


# T. 37 S., R. 6 W., W. M.

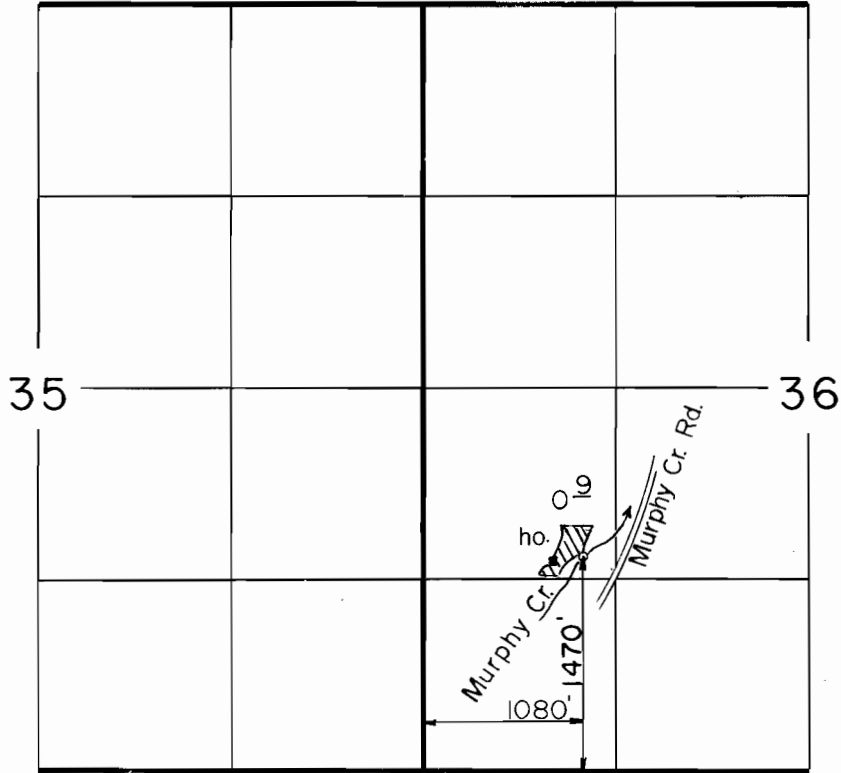

Scale: 1" = 1320'

## FINAL PROOF SURVEY UNDER

Application No. 51709.. Permit No. 38982....  
IN NAME OF

.....JESSE C. NELSON.....

Surveyed APR. 25... 19.88., by B...S...JAMES....