


T.25S. R.4W. W.M.

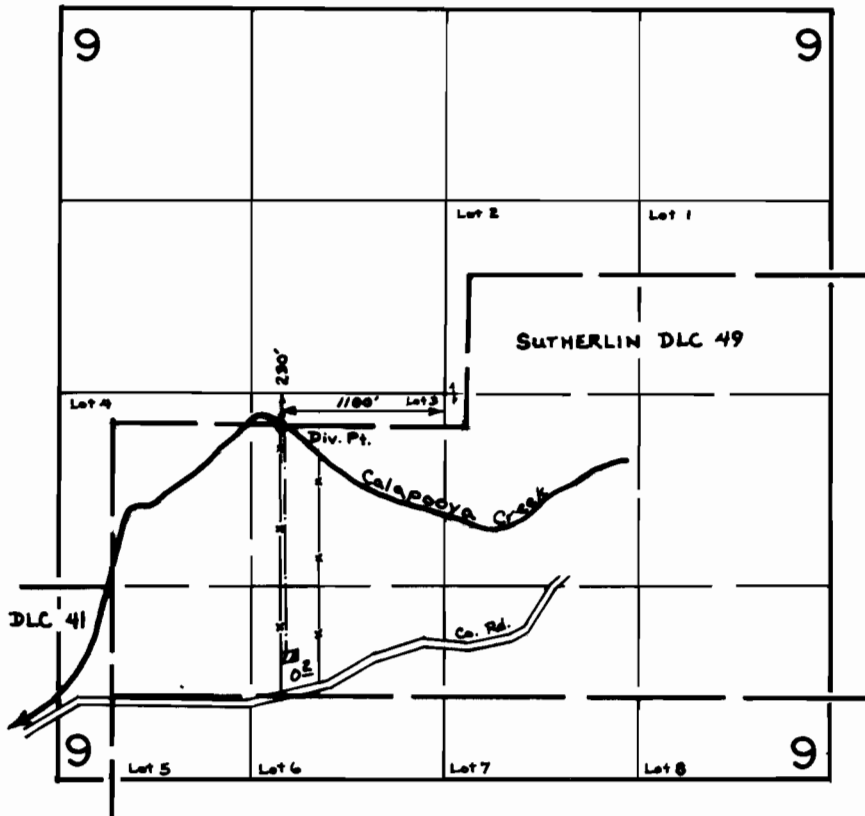

SCALE: 4" = 1 mile

**FINAL PROOF SURVEY**  
UNDER

Application No. 51937... Permit No. 39072....  
IN NAME OF

**SCOTT S. & JUDY A. McALLISTER....**

Surveyed July..17., 1980., by S. Donaldson.....