



T. 2S., R. 45E., W.M.

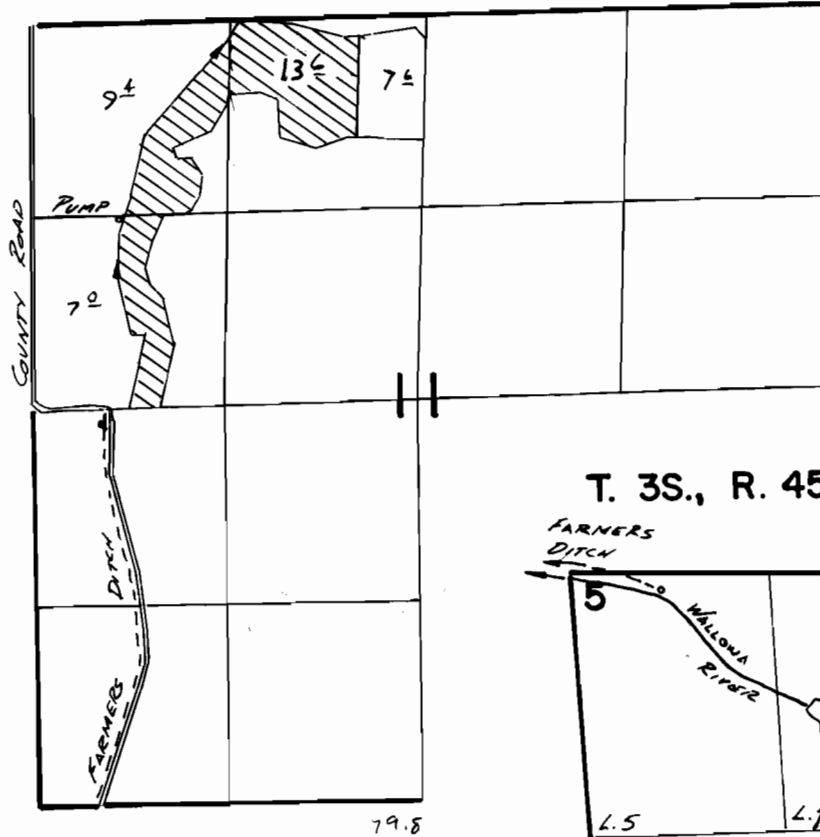

T. 3S., R. 45E., W.M.

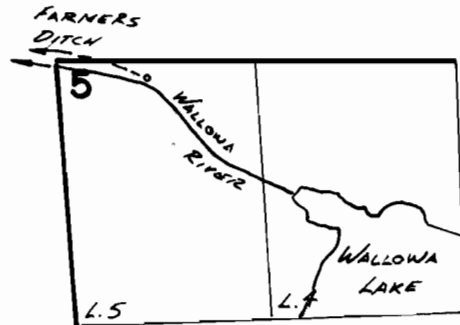

Div. Pt. Loc: 120'S. & 610'E. FROM NW COR. SEC 5

FINAL PROOF SURVEY
UNDER

Application No. 54176 Permit No. 40558
IN NAME OF

DARRELL PERKINS

Surveyed Aug. 22 1978, by R. F. BARNUM