


T. 36 S., R. 7 W., W. M.

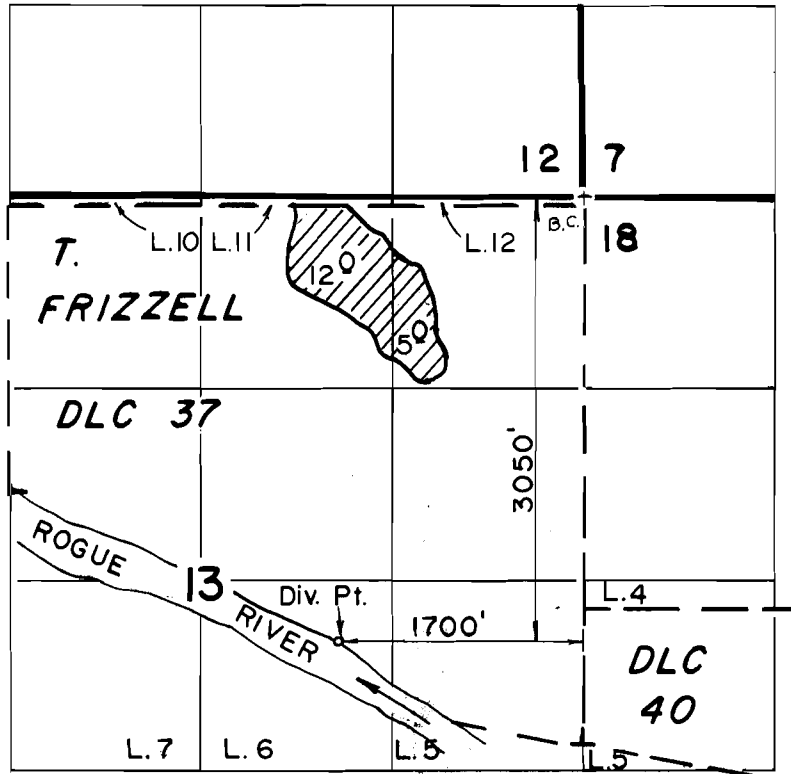

Scale: 1" = 1320'

FINAL PROOF SURVEY
UNDER

Application No. 56292 Permit No. 42734
IN NAME OF

ANTHONY CORNELLA

Surveyed Oct. 6 1988, by B. S. JAMES.