


T.16S., R.9W., W.M.

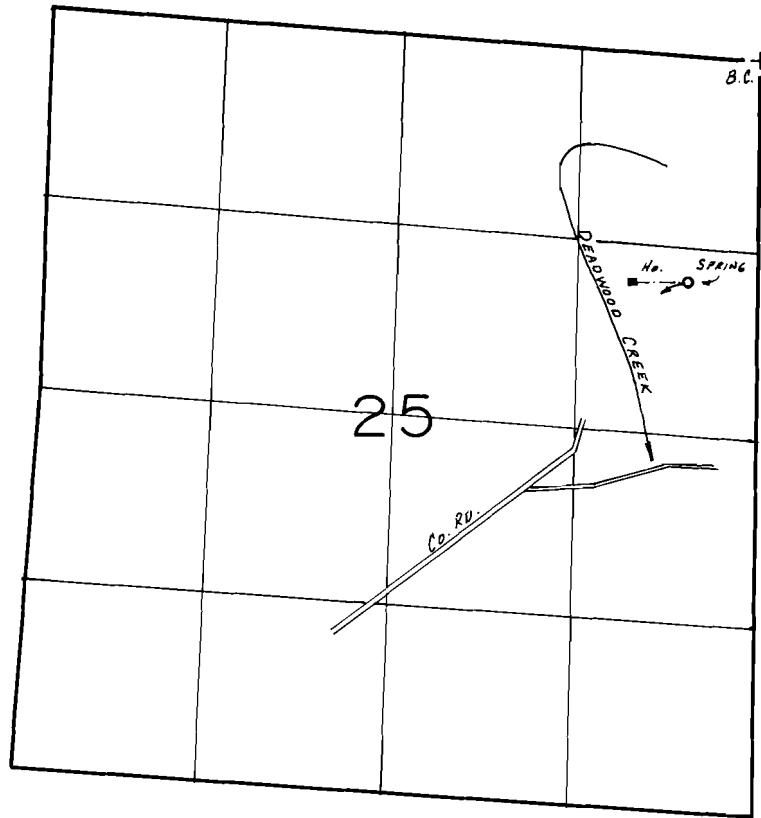

SPRING LOC.: 1520'S. & 500' W. FROM NE COR. SEC. 25.

SCALE: 1" = 1320'

FINAL PROOF SURVEY
UNDER

Application No. 56417 Permit No. 42396
IN NAME OF

GEORGE D. & MARILYN OLDERSHAW

Surveyed June 5 1984, by P.R. PAGTER
July 30 1986 B.W. BISHOP

2/10/87
BWB