


T. 1S., R. 38&4W., W.M.

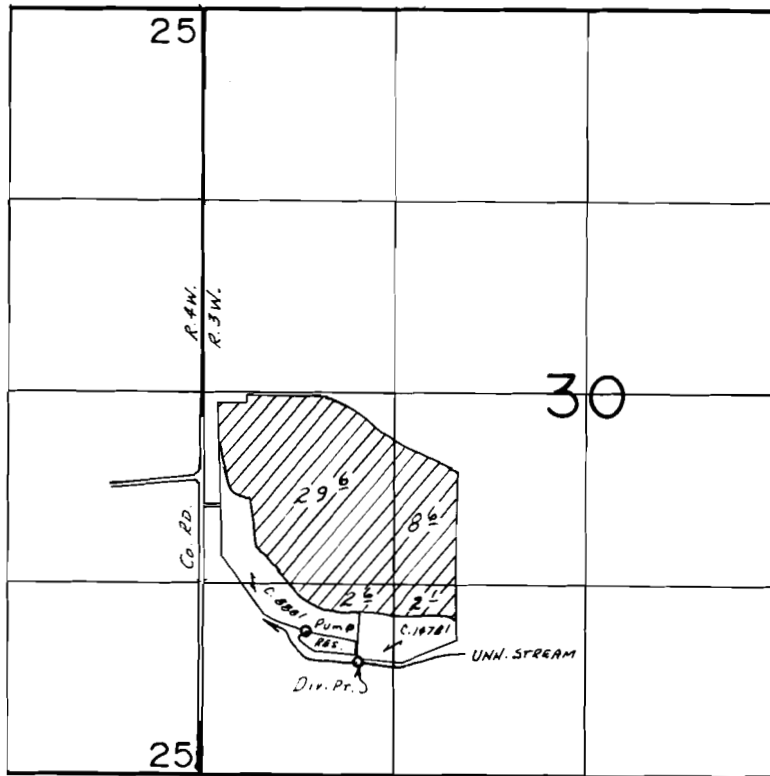

Div. Pt. Loc.: 770' N. & 1080' E. FROM SW COR. SEC. 30.

SCALE: 1" = 1320'

### FINAL PROOF SURVEY UNDER

R-56506                      R-6734  
Application No. 56507... Permit No. 42494...  
IN NAME OF

.....JIM FISHER / FISHER FARMS.....

Surveyed Aug. 11... 1986, by R.W. BISHOP....

1/6/87 BWB

41067-178-109D