


T. 1S., R. 38&4W., W.M.

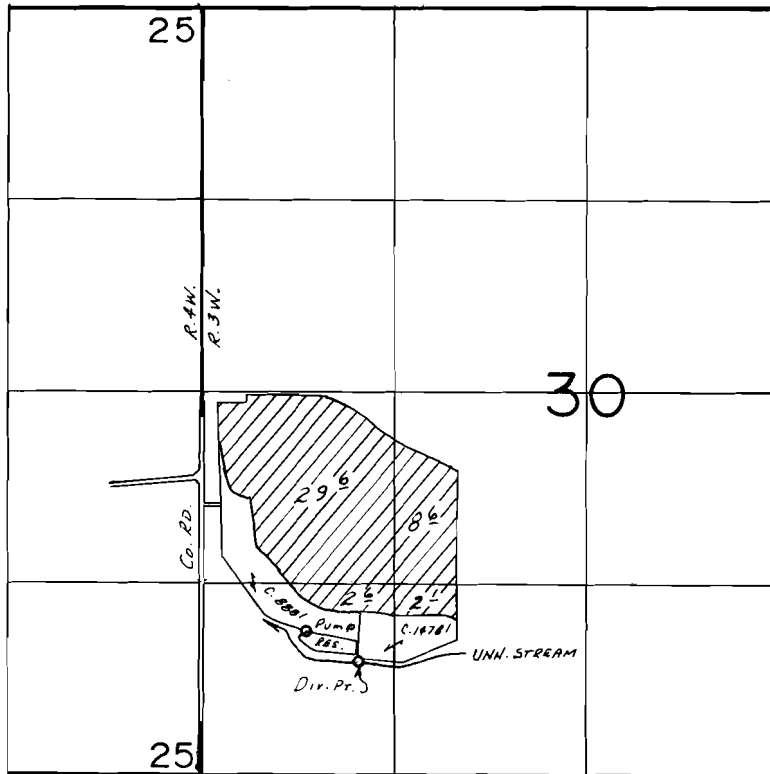

Div. Pt. Loc.: 770' N. of 1080' E. FROM SW COR. SEC 30.

SCALE: 1" = 1320'

### FINAL PROOF SURVEY UNDER

R-56506                      R-6734  
Application No. 56507... Permit No. 42494....  
IN NAME OF

.....JIM FISHER / FISHER FARMS.....

Surveyed Aug. 11... 1986, by B.W. BISHOP....

1/6/87 JWB

41067-178-109D