




T. 7 S., R. 10 & 11 W., W.M.

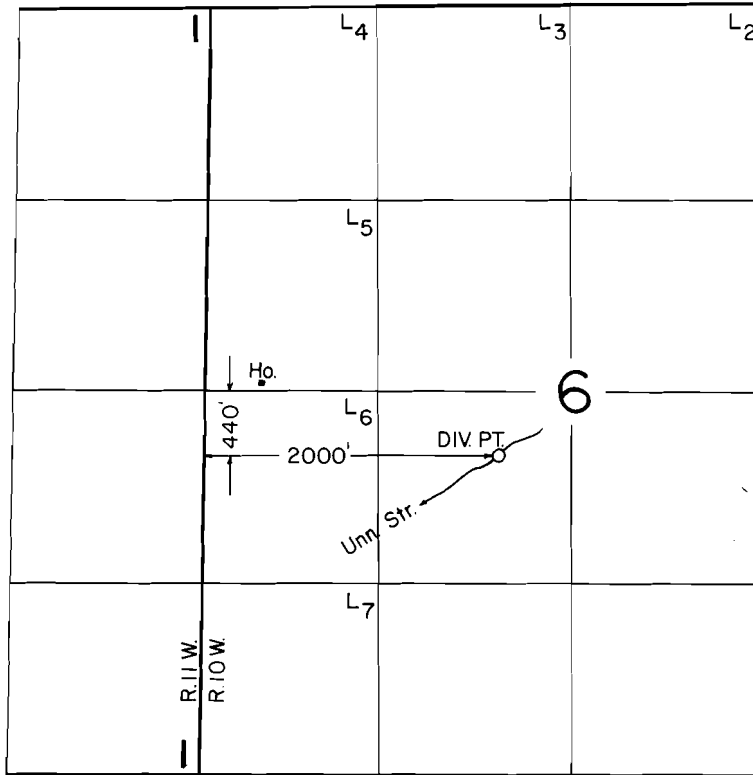

SCALE: 1" = 1320'

FINAL PROOF SURVEY
UNDER

Application No. 56908.. Permit No. 42974.....
IN NAME OF

.....R.L. KIVETT.....

Surveyed JUNE 18, 1986, by T. WARREN.....