


T.36S., R. 7 W., W.M.

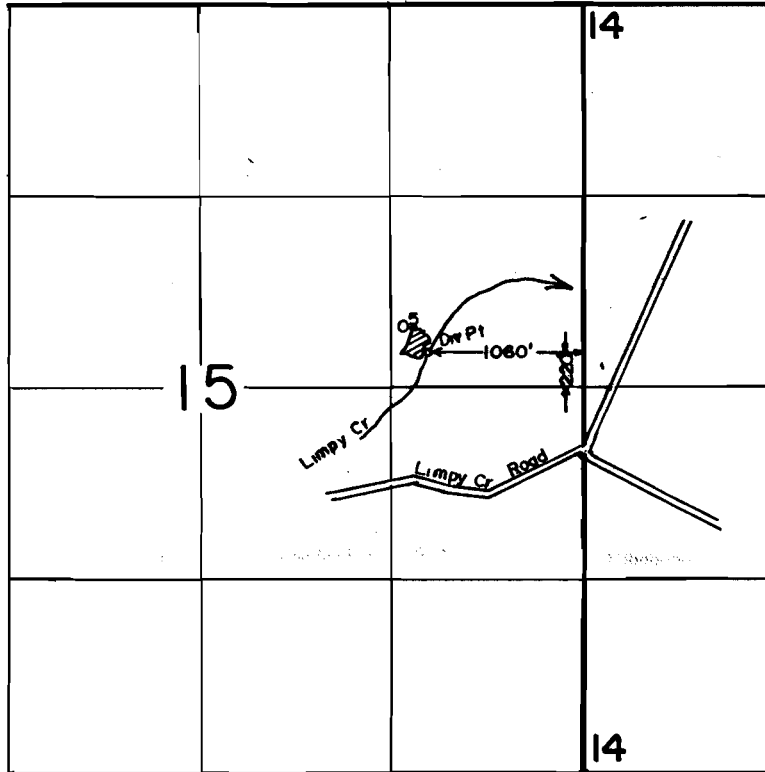

SCALE: 1" = 1320'

FINAL PROOF SURVEY
UNDER

Application No. 57073... Permit No. 42949.....
IN NAME OF

...DIXIE R. & MARY NELL DENTON..

Surveyed MAY 25... 1989., by B.S. JAMES.....