


T. 38 S., R. 3 E., W. M.

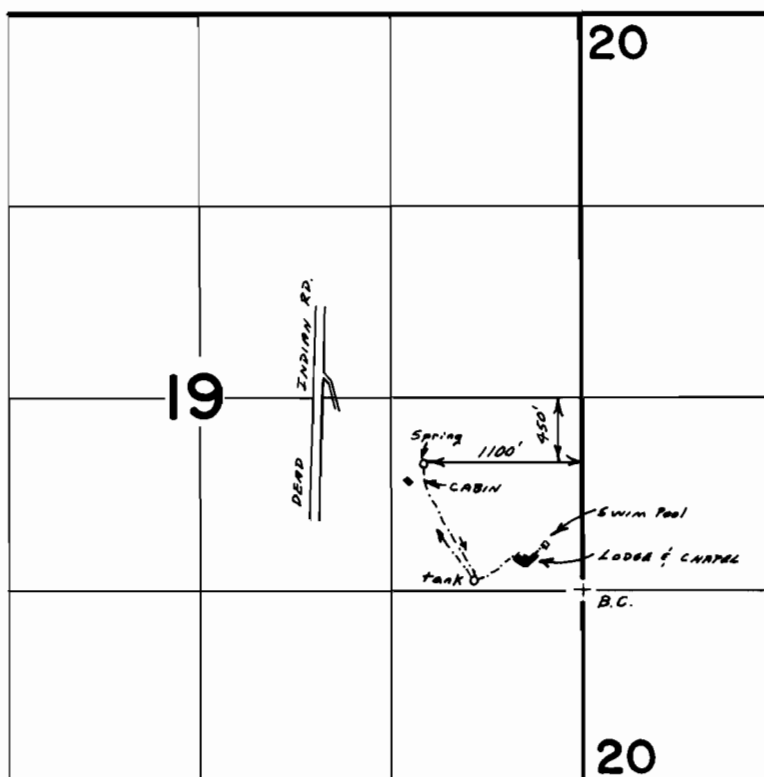

Scale 1" = 1320'

**FINAL PROOF SURVEY**  
UNDER

Application No. **57170** Permit No. **42956**  
IN NAME OF

**FAITH TABERNACLE; c/o: LEO C. WINE**

Surveyed **August 25 1987**, by **B.S. JAMES**