


T. 35 S., R. 5 W., W. M.

RECEIVED

JUL 16 1987

WM. DIST. 114
GRANTS PASS, URE.

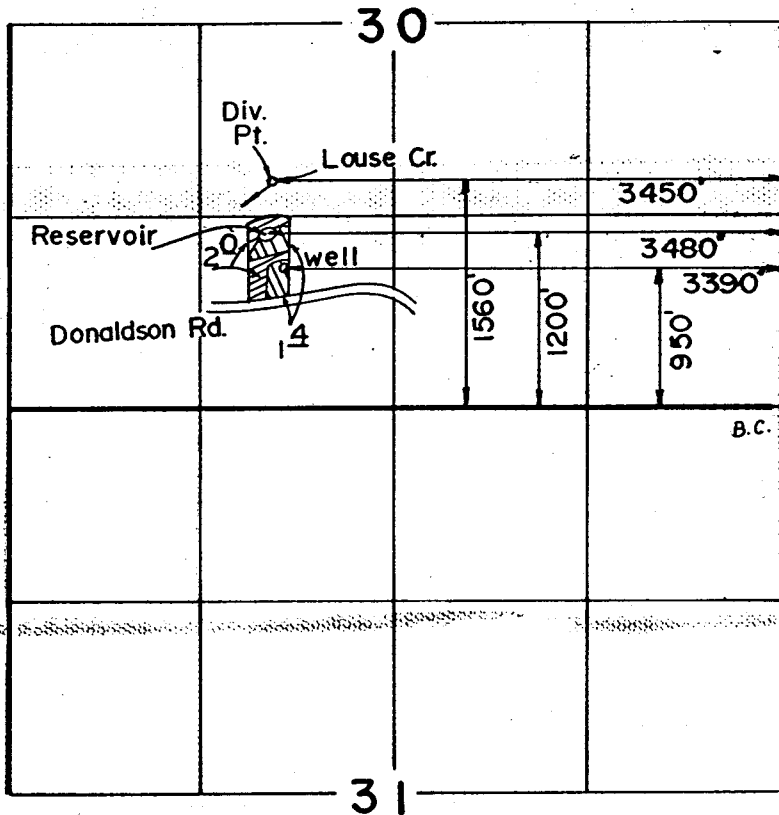

Scale: 1" = 1320'

Suppl. from Well 

Primary from Well 

All Land Suppl. From Reservoir.

FINAL PROOF SURVEY

UNDER
TRANSFER NO. 4115
R-58204 R-7837
58205 44287

Application No. G-9063. Permit No. G-8611.....
IN NAME OF

.....JOHN.....BEELER.....

Surveyed JUL. 28. 1987., by B. S. JAMES....