


T.37S., R.14&15W., W.M.

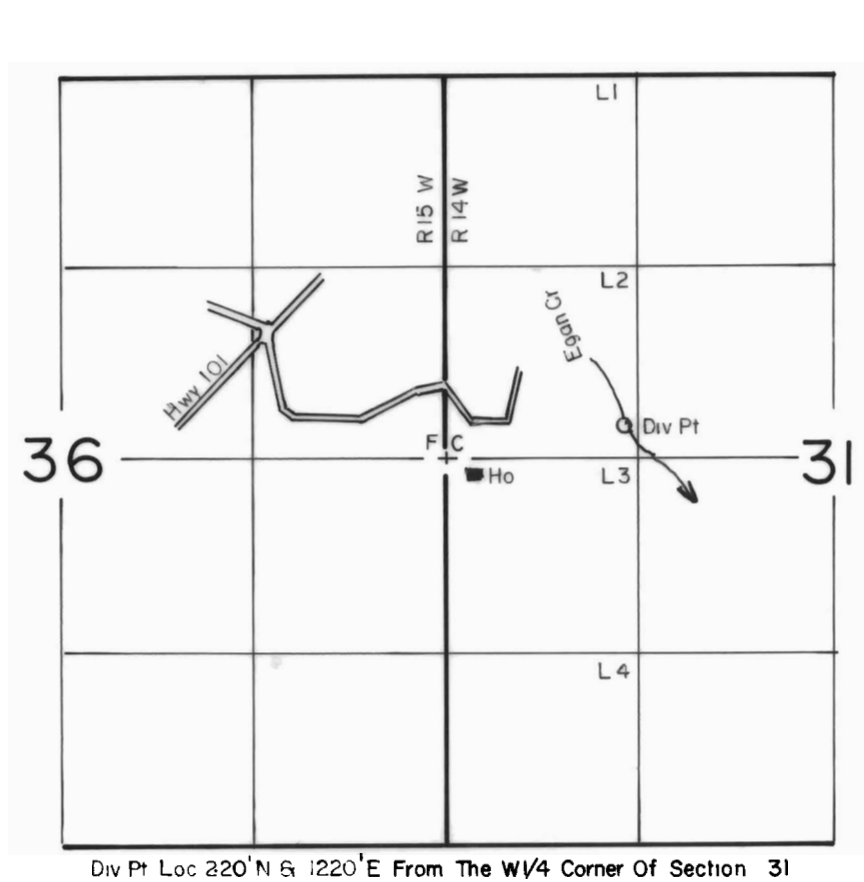

Div Pt Loc 220' N & 1220' E From The W/4 Corner Of Section 31

SCALE: 1" = 1320'

FINAL PROOF SURVEY UNDER

Application No. 58319... Permit No. 43939...
IN NAME OF

...A. E. & MARJORIE... FRAZIER...

Surveyed JULY 28, 1989, by B.S. JAMES...