

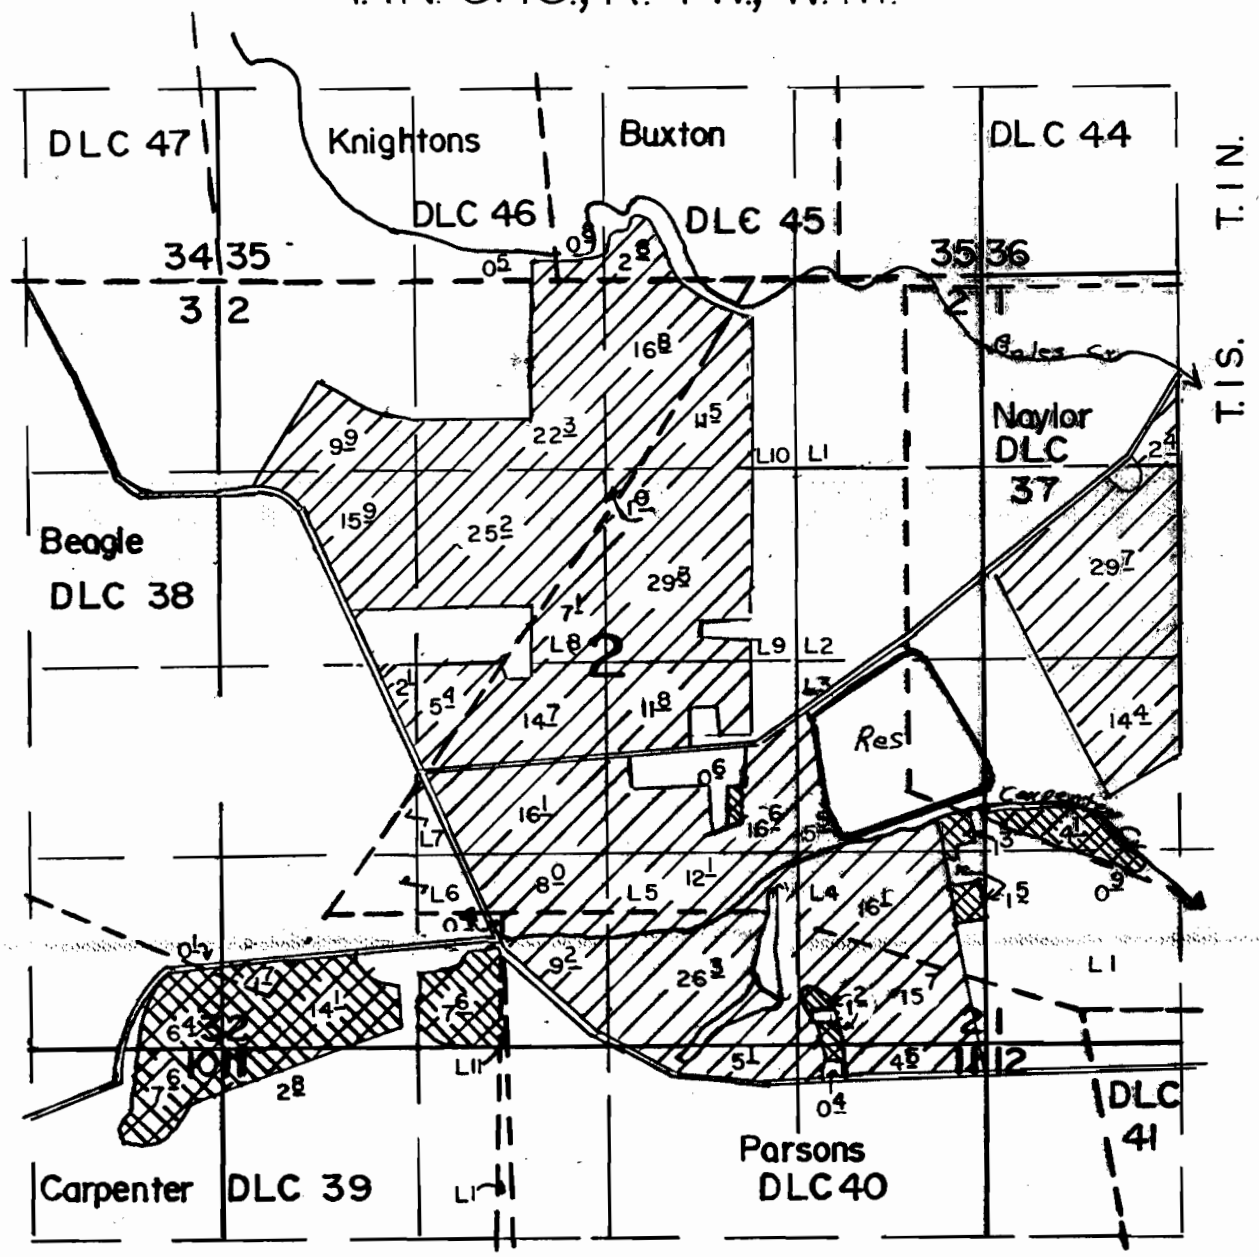


# T.1N. & IS., R.4W., W.M.

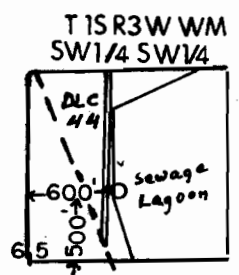

SCALE: 1" = 1320'

## FINAL PROOF SURVEY UNDER

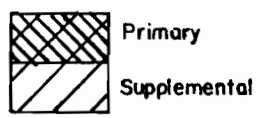

R-58694                      R-8808  
 Application No. 64769..... Permit No. 47713.....  
 IN NAME OF

**OREGON GARDEN PRODUCTS INC.**

Surveyed JULY 11, 1989, by T.M. WARREN