

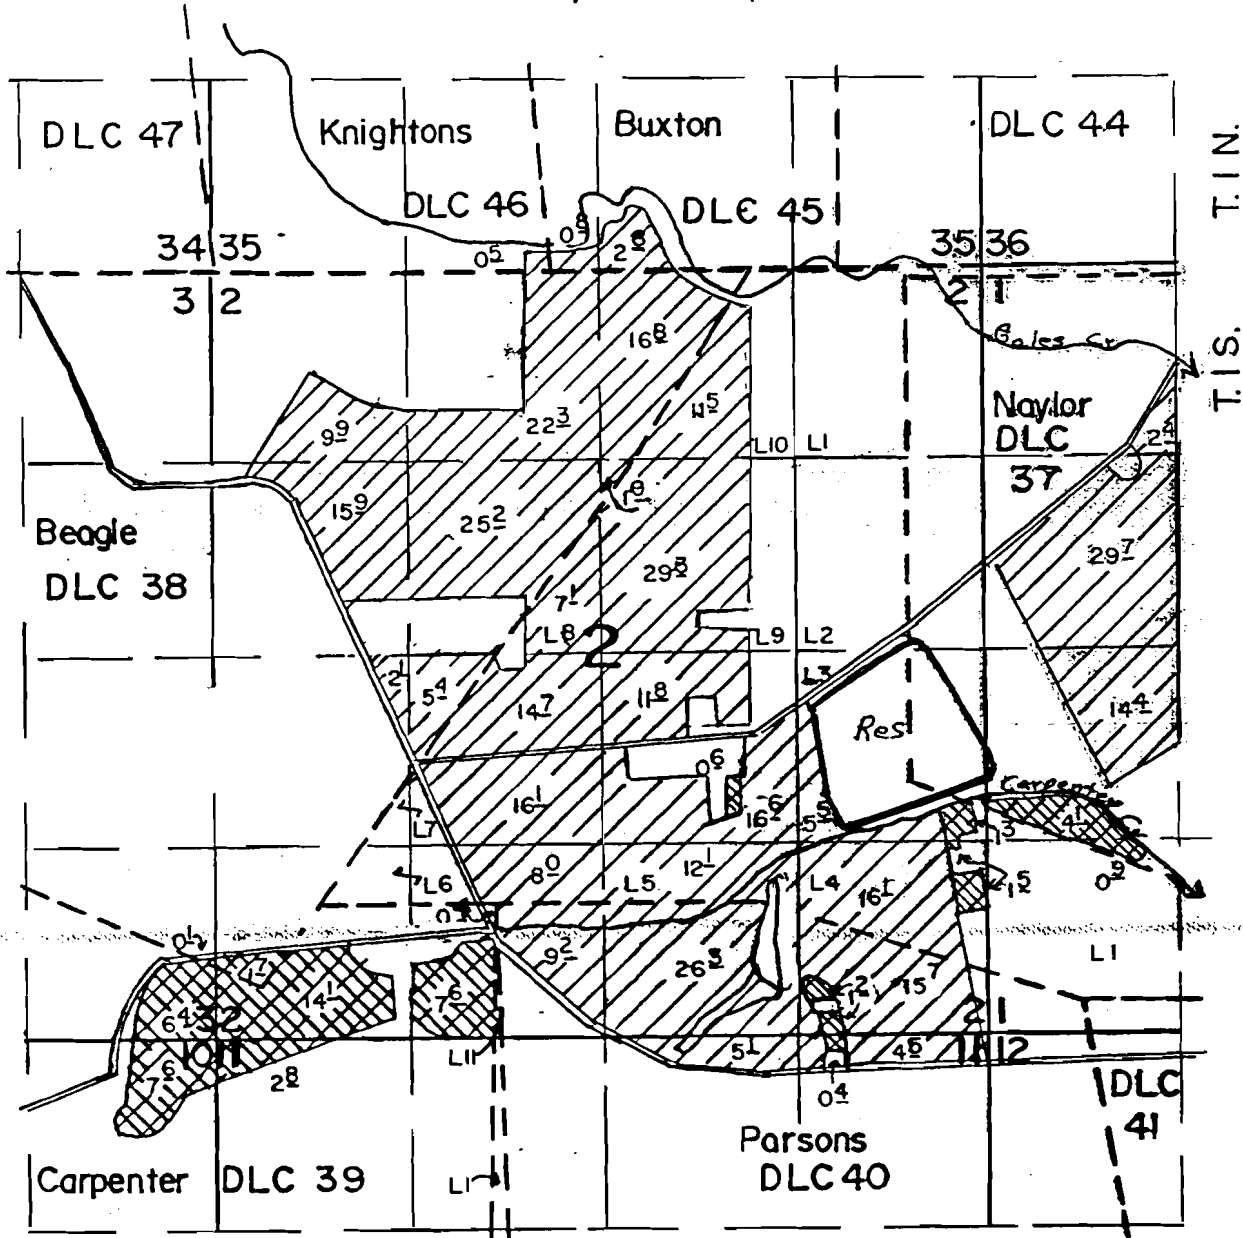


T.1N. & IS., R.4W., W.M.

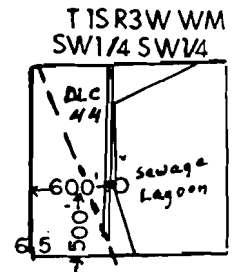

SCALE: 1" = 1320'

FINAL PROOF SURVEY UNDER

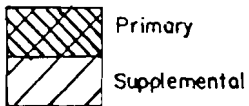

R-58694 R-8808

Application No. 64769..... Permit No. 47713.....
IN NAME OF

..OREGON..GARDEN..PRODUCTS..INC..

Surveyed JULY 11..... 1989., by T.M. WARREN.....