


T.13S., R.42E., W.M.

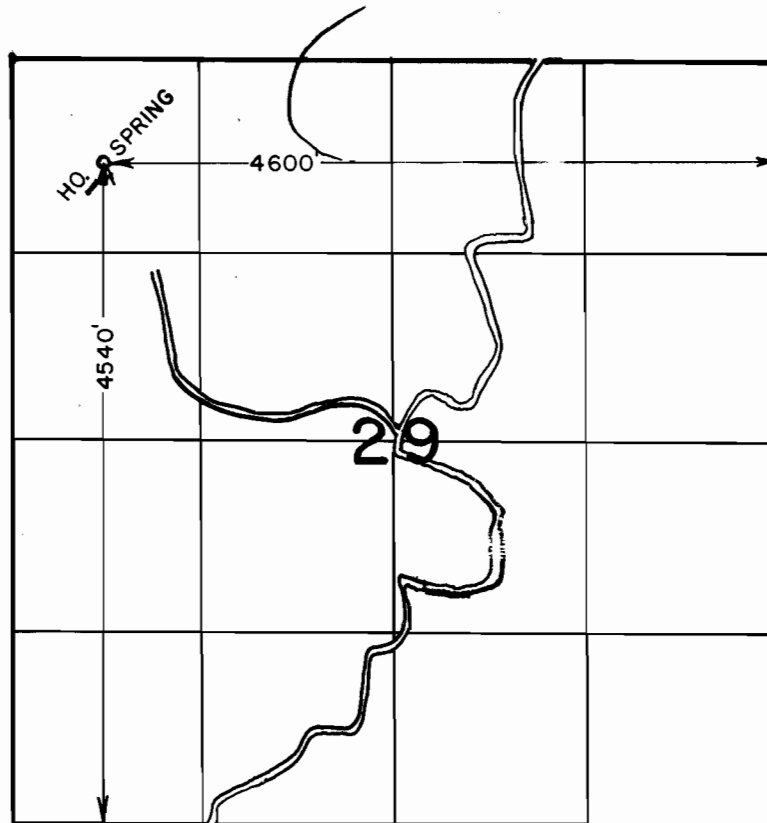

SCALE 1" = 1320'

FINAL PROOF SURVEY
UNDER

Application No. 61225... Permit No. 46369...
IN NAME OF

JOE ANDERSON & LARRY MENDIOLA

Surveyed SEP. 16, 1985, by L.M. TOLL