


T.13S., R.15E., W.M.

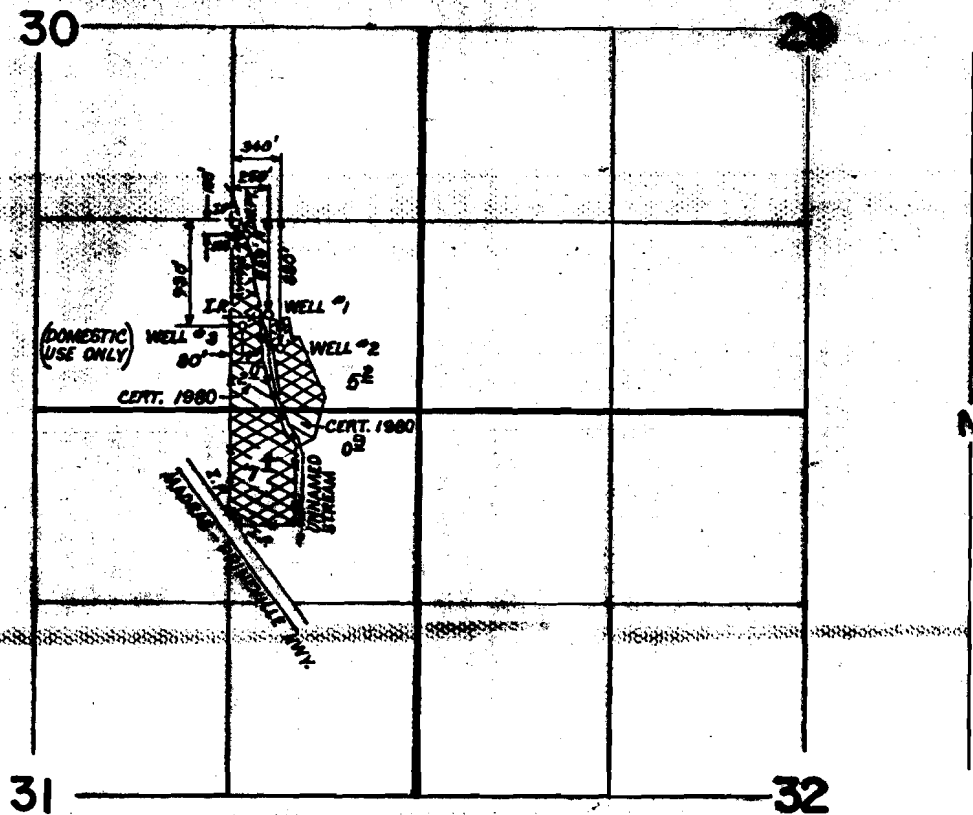

FINAL PROOF SURVEY
UNDER

G-10188 G-9521  ^{supp}
Application No. 61303 Permit No. 46168 — Cert. # 64285
IN NAME OF

ROYCE N. & SANDRA D. KIRK

Surveyed JULY 2, 1985, by LESLIE OLSON