


T. 13S., R. 29E., W. M.

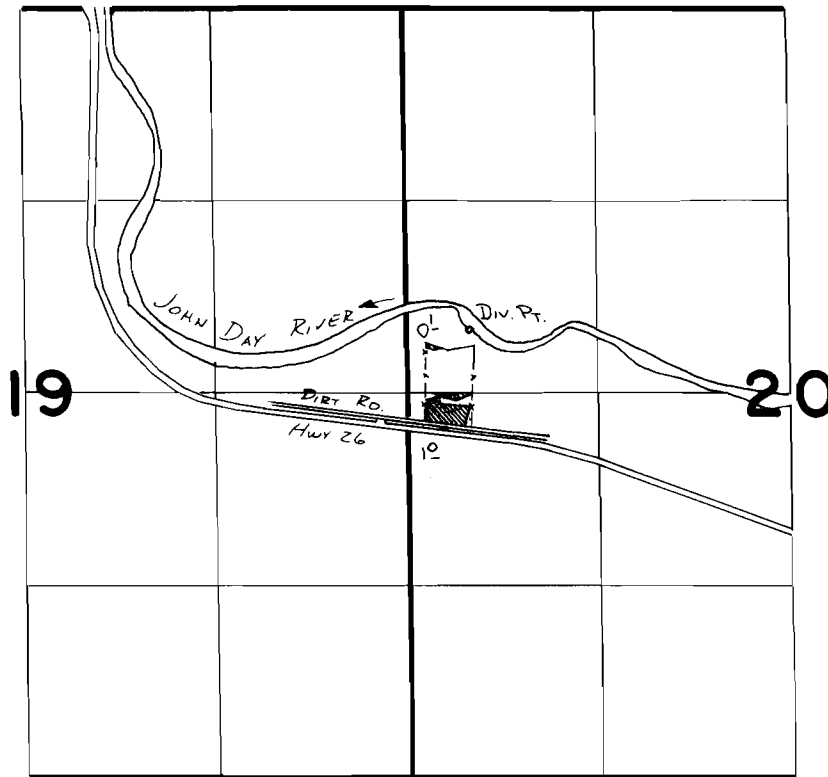

SCALE 1" = 1320'

Div. Pt. Loc: 430' N. & 430' E. FROM W 1/4 COR. SEC. 20

FINAL PROOF SURVEY
UNDER

TRANSFER 4745

Application No. **61498** Permit No. **45675**

IN NAME OF

RALPH B. & NORMA J. NETH

Surveyed 4-8-1986, by V. h. Church