


Township 1S Range 11E

Scale 4" = 1 Mile

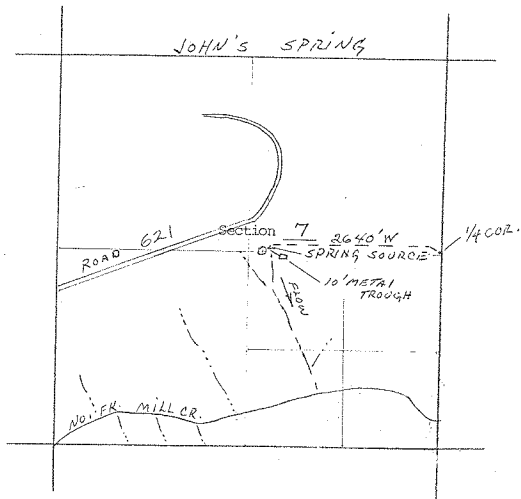

Application No. 61513

Permit No. 46458

**RECEIVED**

JUL 31 1981

WATER RESOURCES DEPT  
SALEM, OREGON