


T. 39 S., R. 3 W., W.M.

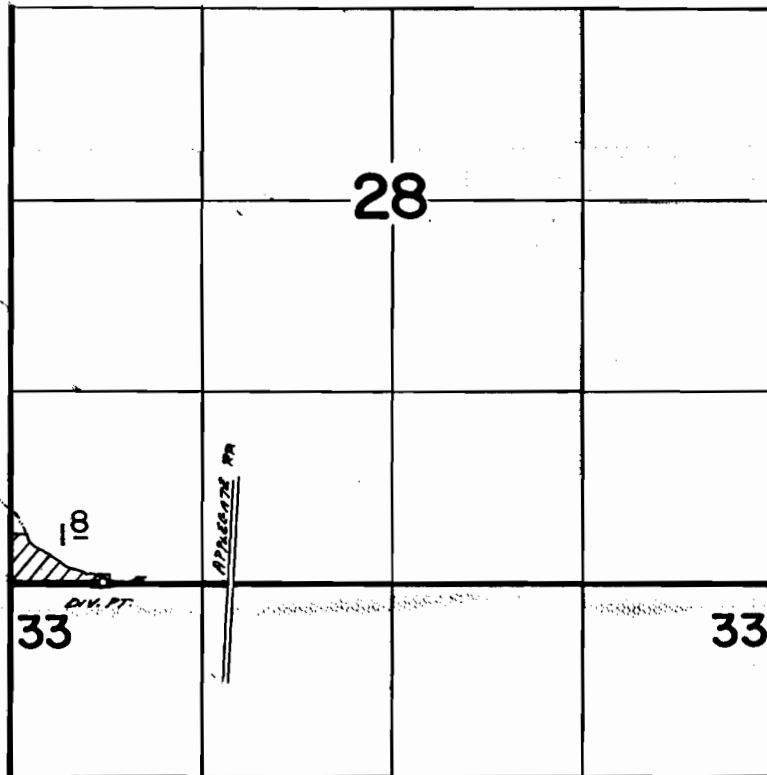

DIV. PT.: 30' N AND 630' E FROM SW CORNER OF SECTION 28

Scale 1" = 1320'

FINAL PROOF SURVEY UNDER

Application No. 61557 Permit No. 46009
IN NAME OF

LOREN R. GINGG

Surveyed Nov. 13. 1987. by B.S. JAMES