


T. 39S., R. 5 W., W. M.

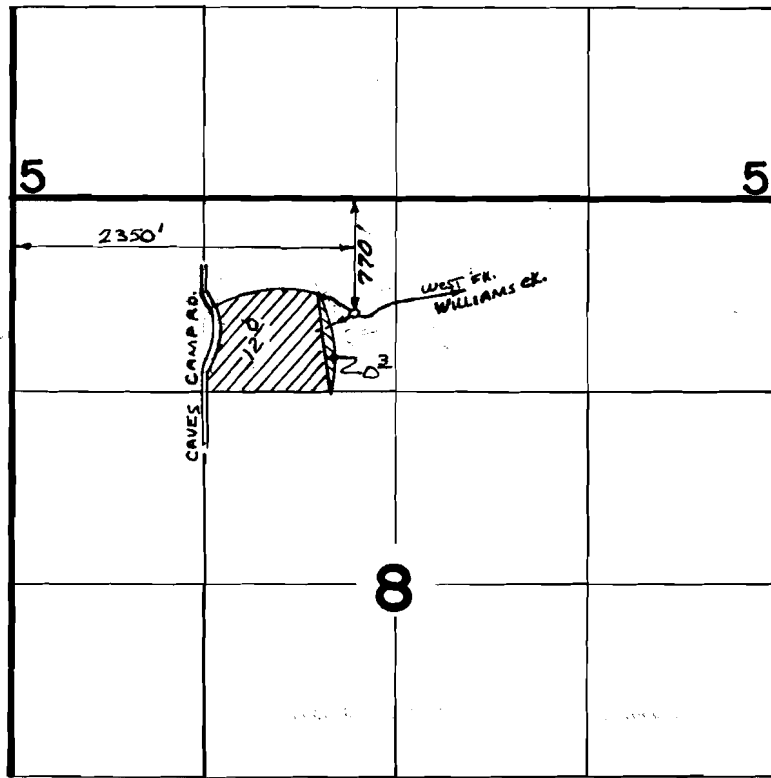

SCALE : 1" = 1320'

FINAL PROOF SURVEY
UNDER

Application No. 61910 Permit No. 46540
IN NAME OF

...SANDRA J. FICKES.....

Surveyed AUG. 14 1984, by B.S. JAMES.....