Application No. 61930
Permit No. 46273

RECEIVED
FEB 4 1988
WATER RESOURCES DEPT.
SALEM, OREGON
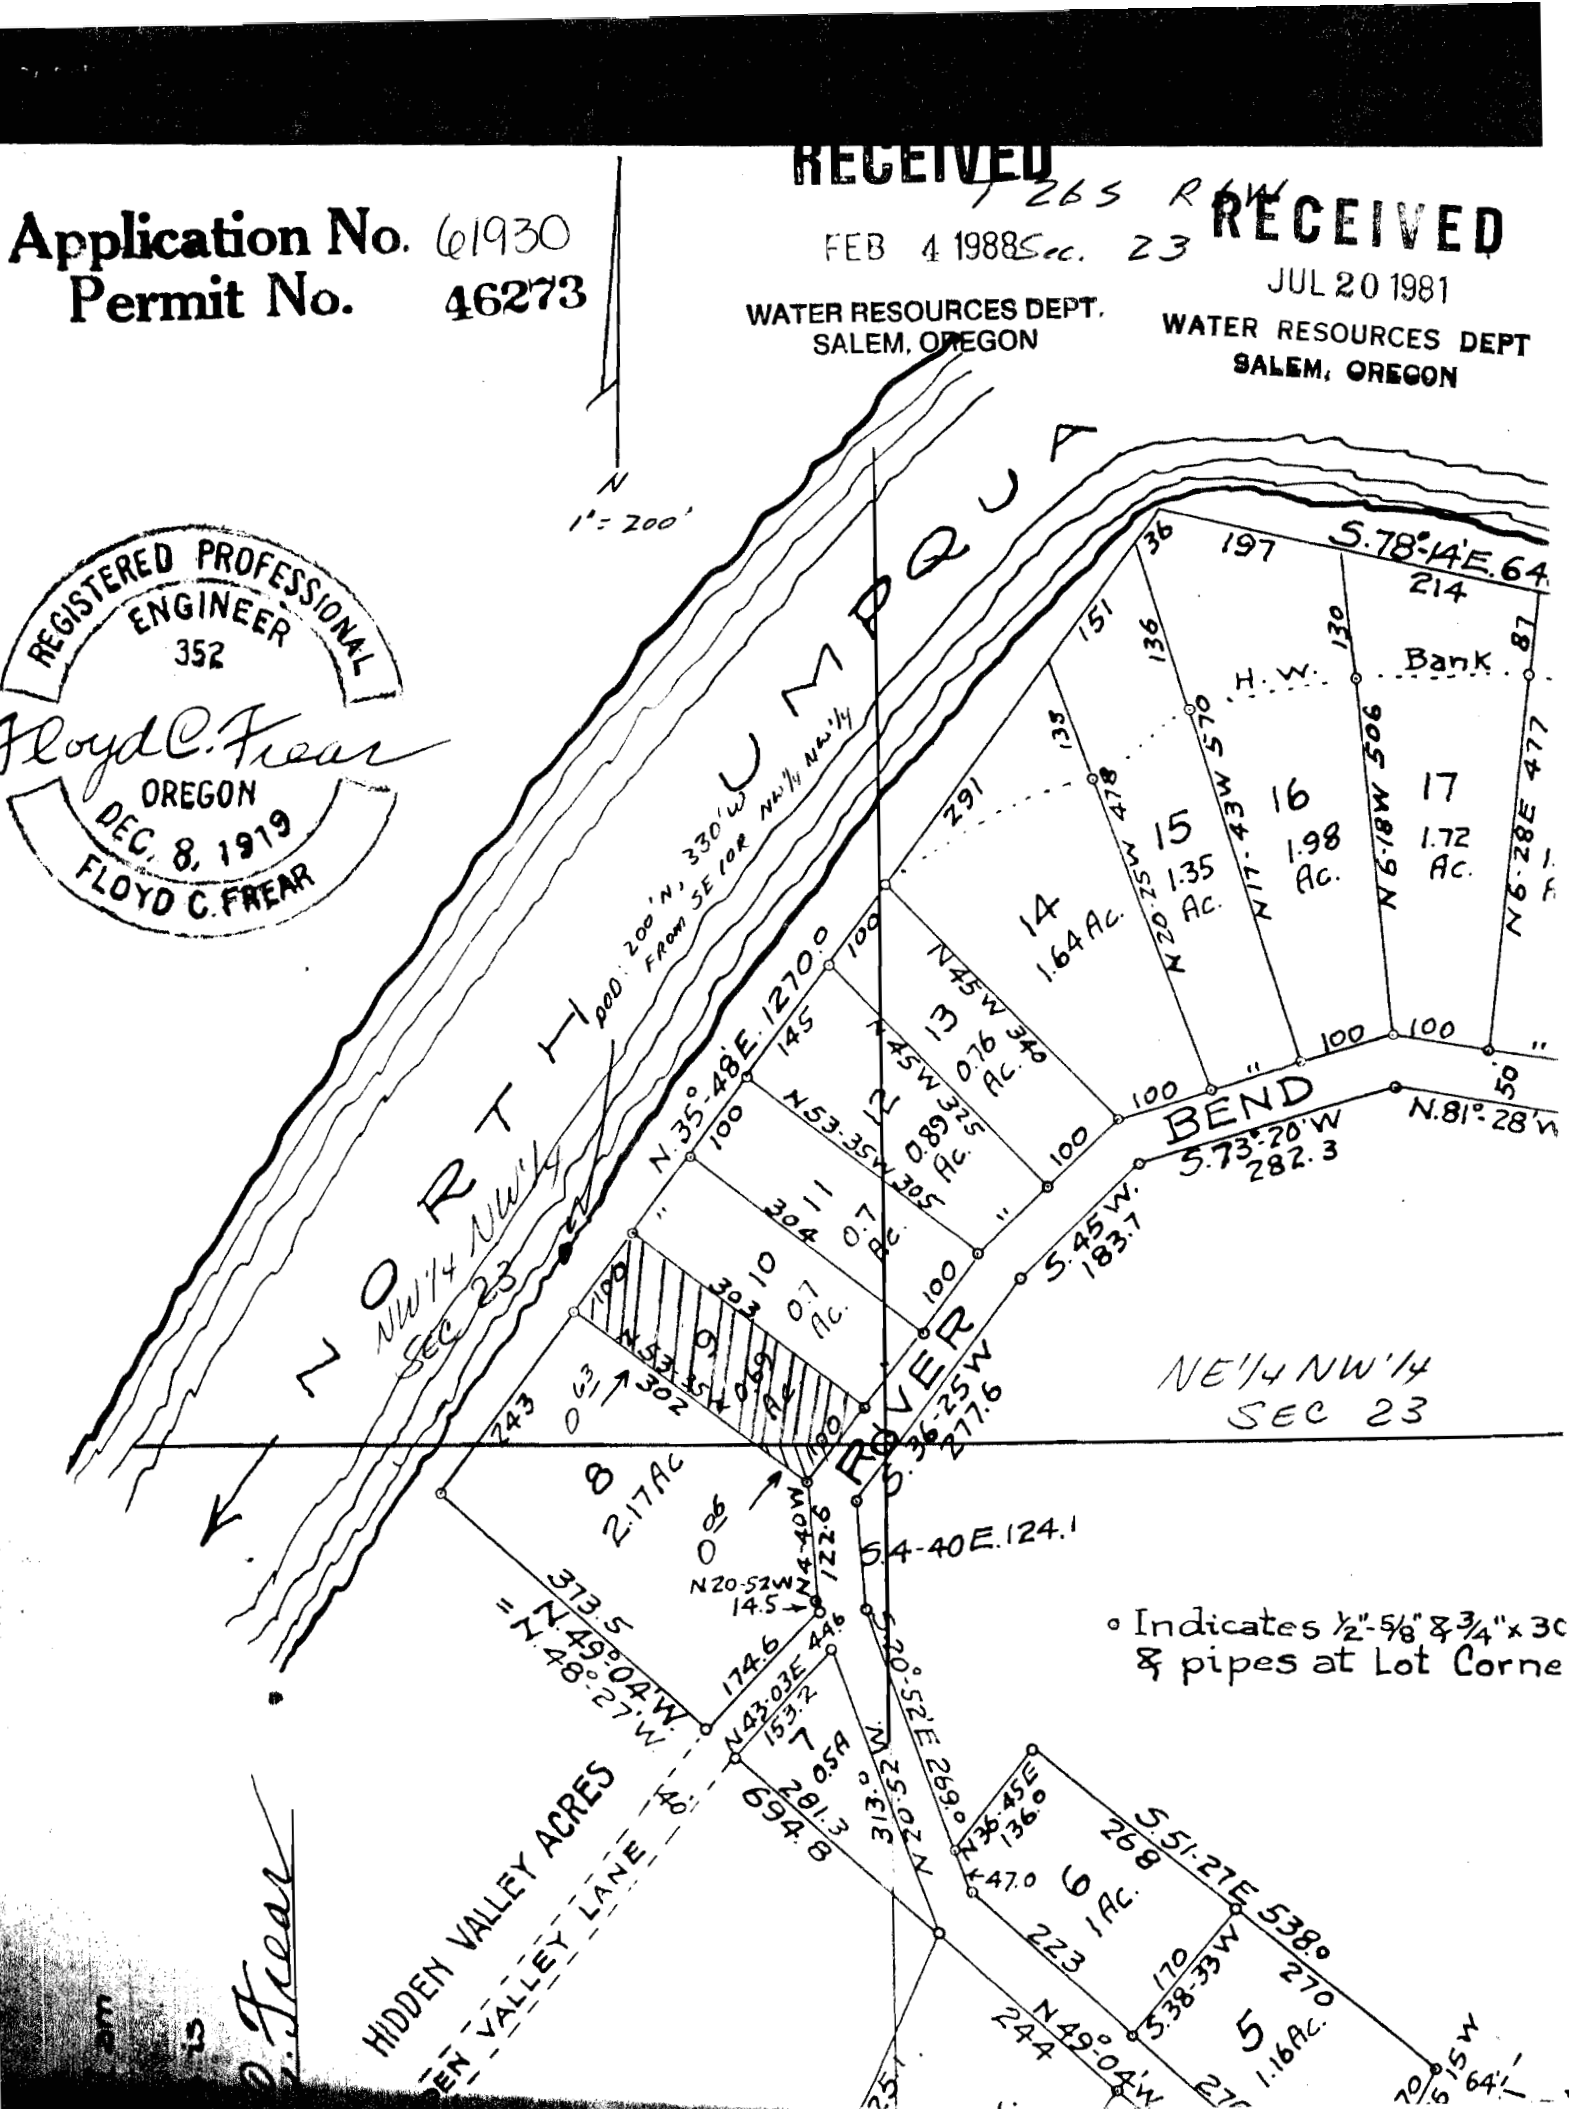
RECEIVED
JUL 20 1981
WATER RESOURCES DEPT
SALEM, OREGON