


T. 33 S., R. 1 W., W.M.
SEC. 36

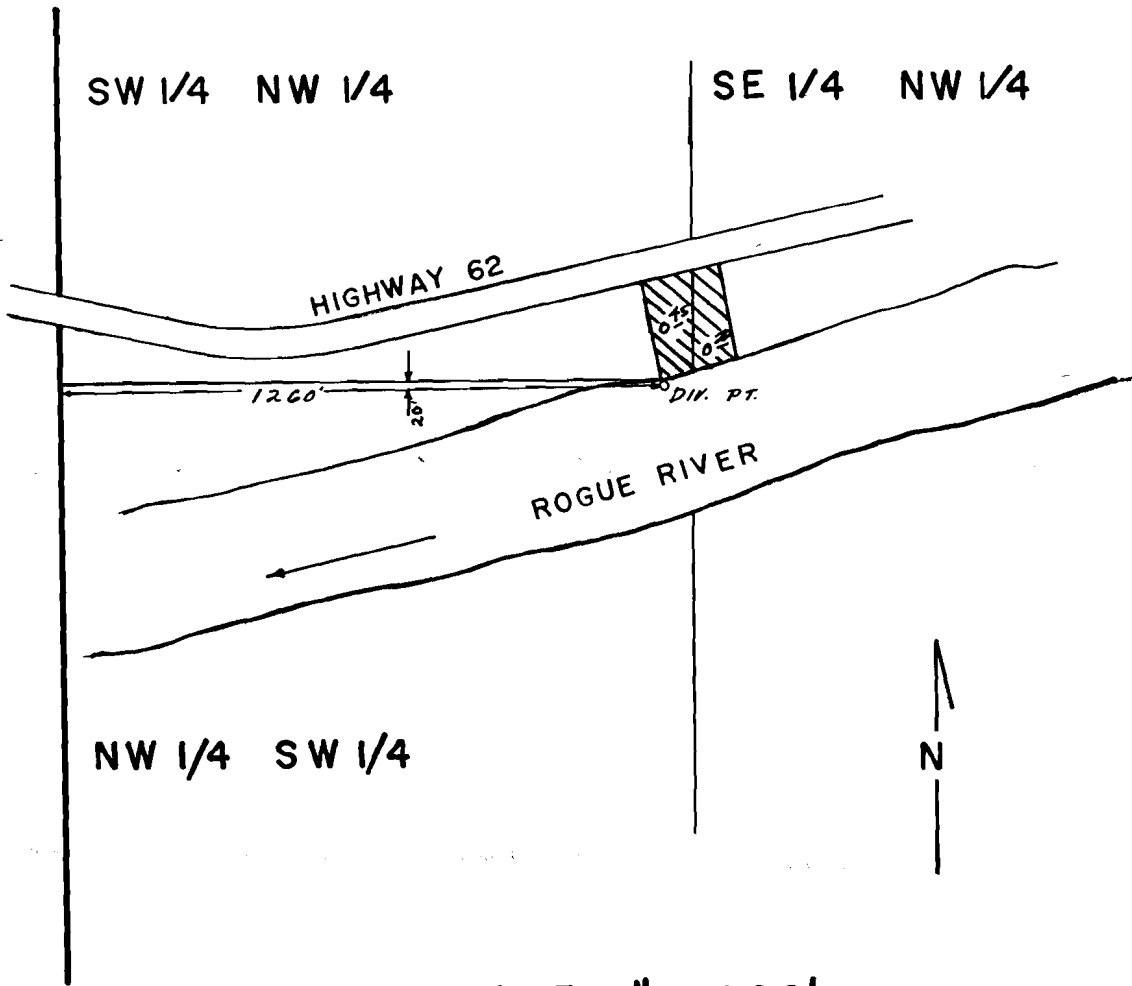

SCALE: 1" = 400'

FINAL PROOF SURVEY
UNDER

Application No. 62900 Permit No. 46603
IN NAME OF

WARREN E. & JOAN A. SEMSCH

Surveyed O.C.T. 15, 1985, by B.S. JAMES