


T. 39S., R. 5W., W.M.

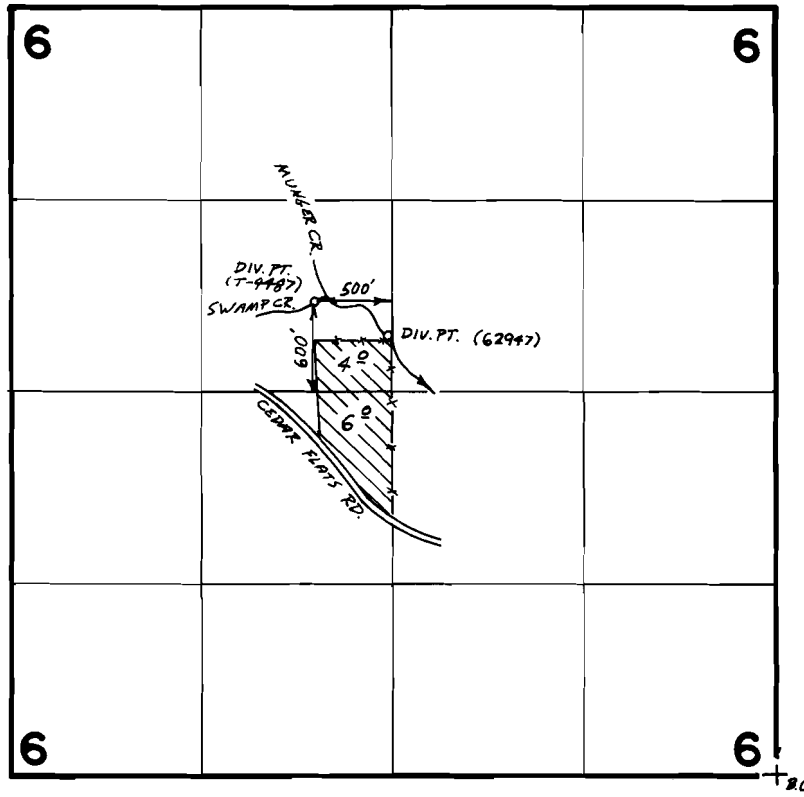

MUNGER CR. DIV. PT. = 380' N & 10' W FROM CENTER OF SEC. 6.

Scale 1" = 1320'

**FINAL PROOF SURVEY**

UNDER

Transfer No. 4487

Application No. 62947.. Permit No. 46645.....

IN NAME OF

PEARL HART

Surveyed AUG. 15, 1985, by B.S. JAMES.....