


T. 6N., R. 2W., W.M.

Sec. 32

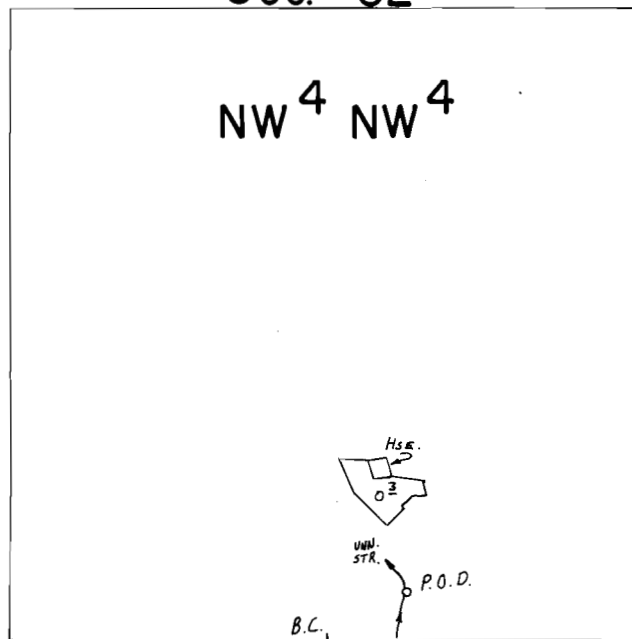

P.O.D. Loc. : 100' N. & 115' E. from SW Cor. of SE⁴ NW⁴ NW⁴, Sec. 32.

Scale : 1" = 400'

FINAL PROOF SURVEY UNDER

Application No. 62978.. Permit No. 46631.....

IN NAME OF

JAMES LEINBACH

Surveyed JUNE...5... 1986., by ..T..Warren.....

PTS-1986-A
1/8/87 TMW