


T. 8N., R. 3W., W.M.

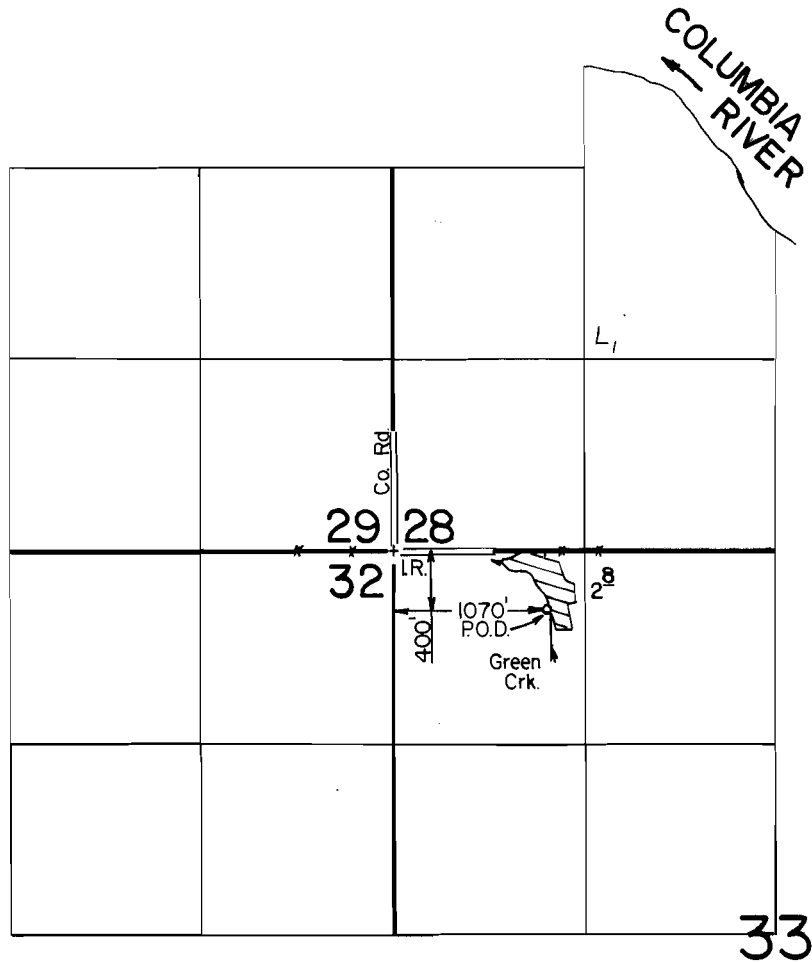

Scale : 1" = 1320'

FINAL PROOF SURVEY
UNDER

Application No. 63032.. Permit No. 46638.....
IN NAME OF

JEFFREY ROBERT HOWLETT

Surveyed AUG. 13. 1986, by T. WARREN

PTS-1986-C.
3/13/87 TMW