


T. 4 S., R. 1 E., W. 1 M.

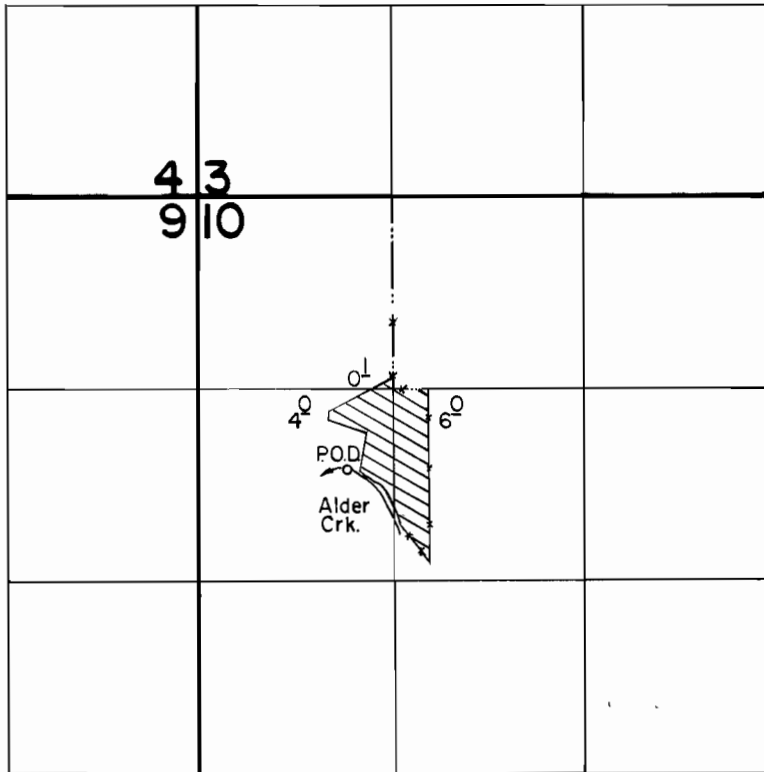

P.O.D. Loc. 760' N. & 1620' W. from C. 1/4 Sec. 10.

Scale: 1" = 1320'

FINAL PROOF SURVEY UNDER

Application No. 63380.. Permit No. 46447.....
IN NAME OF

.....ROY T. SWEETEN.....

Surveyed JULY 1, 1986., by J. Warren.....

PTS-1986-A
TMW 1/26/87