


T.3&4S,R.5W,W.M.

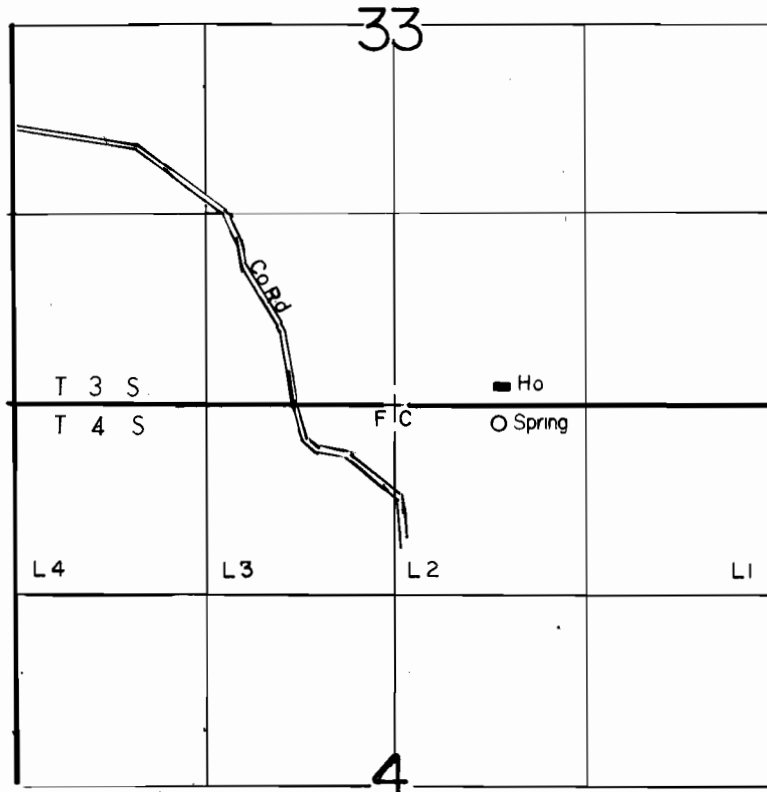

Spring Located 100' S. & 700' E. From The N1/4 Corner Of Section 4

SCALE: 1"=1320'

FINAL PROOF SURVEY UNDER

Application No. 65809... Permit No. 48271.....
IN NAME OF

J. M. KERR, K. D. KERR & MARJORIE BAUER

Surveyed MAY...J.... 1989., by J. M. WARREN.....