


T. 22 S., R. 5 W., W. M.

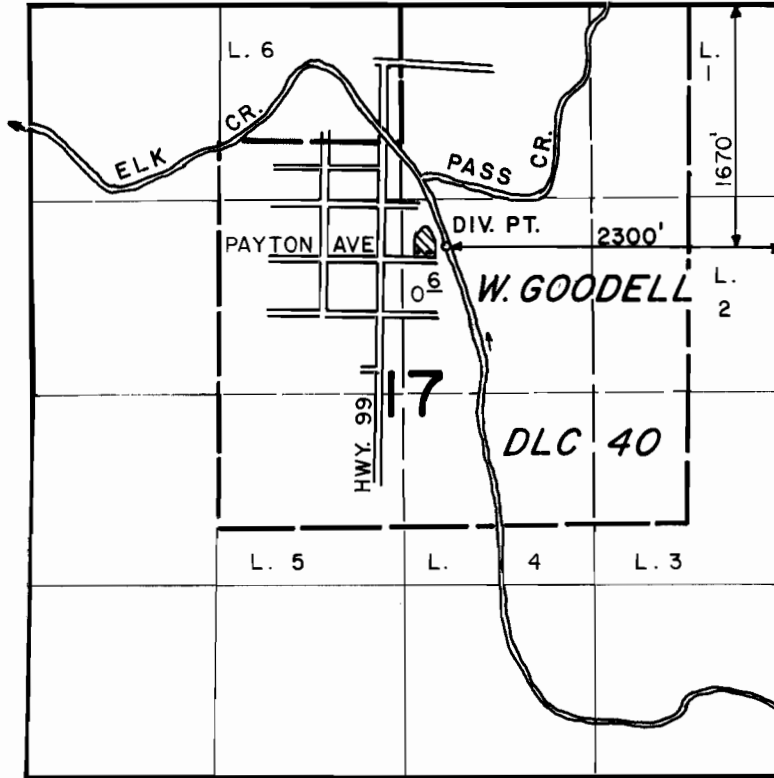

SCALE: 4" = 1 MILE

FINAL PROOF SURVEY UNDER

Application No. 69137... Permit No. 50075...
IN NAME OF

DEXTER D & HELEN V HENDERSON

Surveyed AUG. 4... 1988, by J. M. SCHMORDE