


# T. 11 S. R. 11 W. W.M.

SW 1/4 SE 1/4 SEC. 4  
LINCOLN COUNTY, OREGON

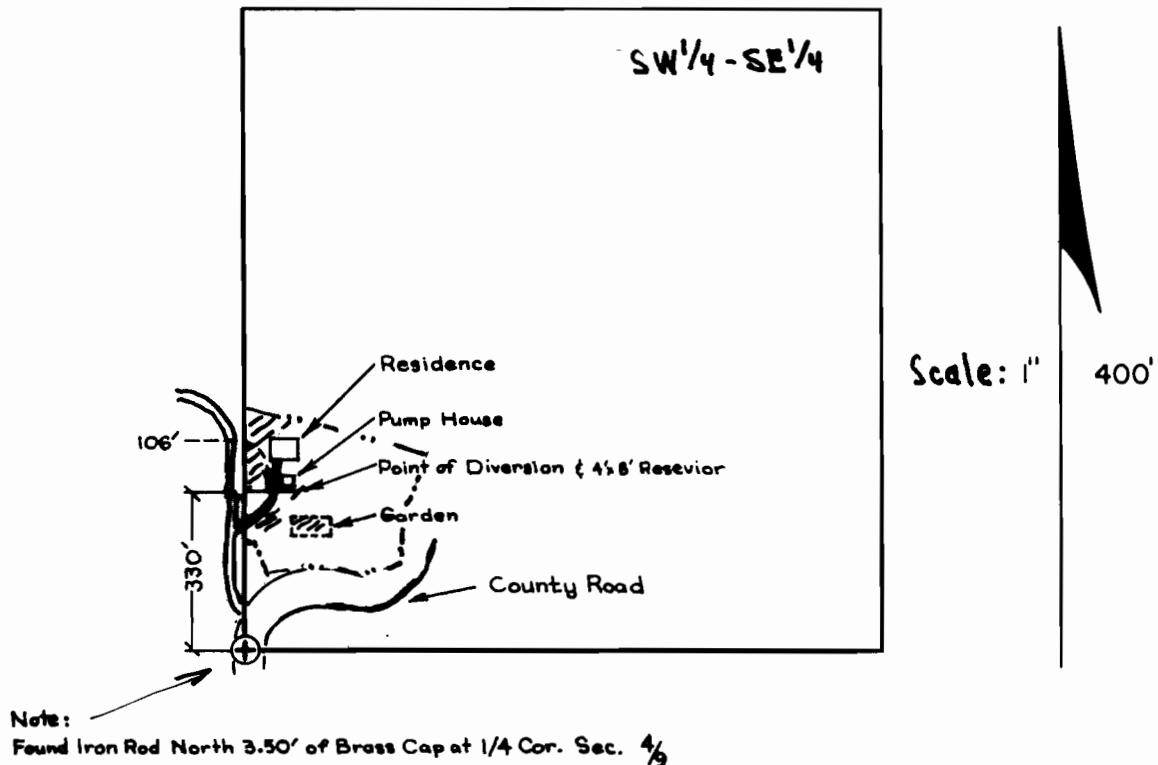

*James M. Denison*

## FINAL PROOF SURVEY UNDER

Application No. 69284 Permit No. 50142

IN NAME OF

WILLIAM R. & PAMELA A. ROGERS

Surveyed Jan. 20 1988 by

*James M. Denison*

This map prepared solely for the purpose of showing the location of a water right, and is not intended for use to provide dimensions or locations of property ownership lines.