


T.31S. R.15 W. W.M.

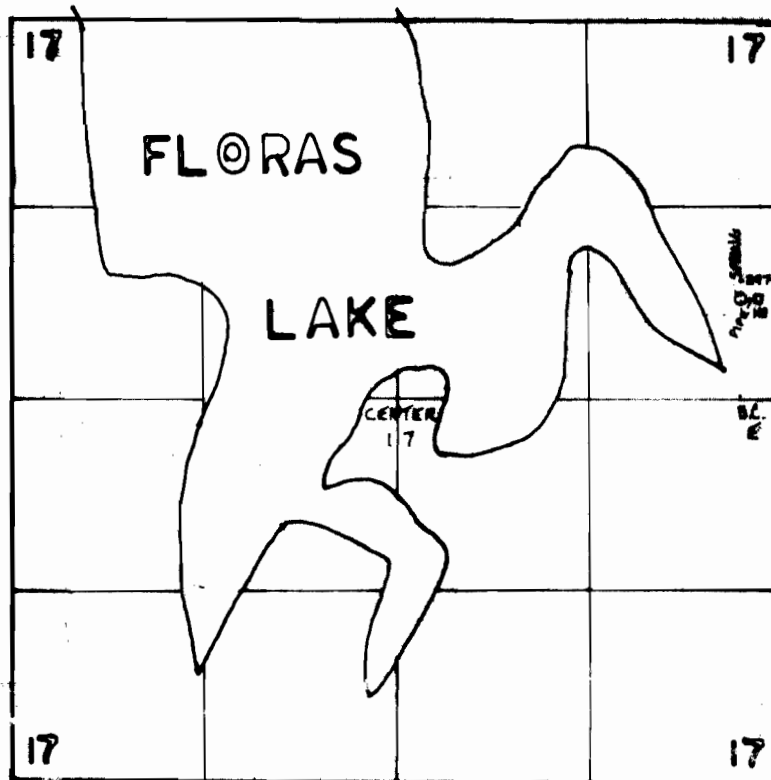

1"=1320'

**FINAL PROOF SURVEY
UNDER**

APPLICATION: 69408 PERMIT: 5043B

IN NAME OF:

KENNETH CARROLL THOMPSON

AUG. 29, 1989

BY: JOHN P. PRAHAR, EURE: #107



RECEIVED

DEC 11 1989

**WATER RESOURCES DEPT.
SALEM, OREGON**