


SEC. 36.

36

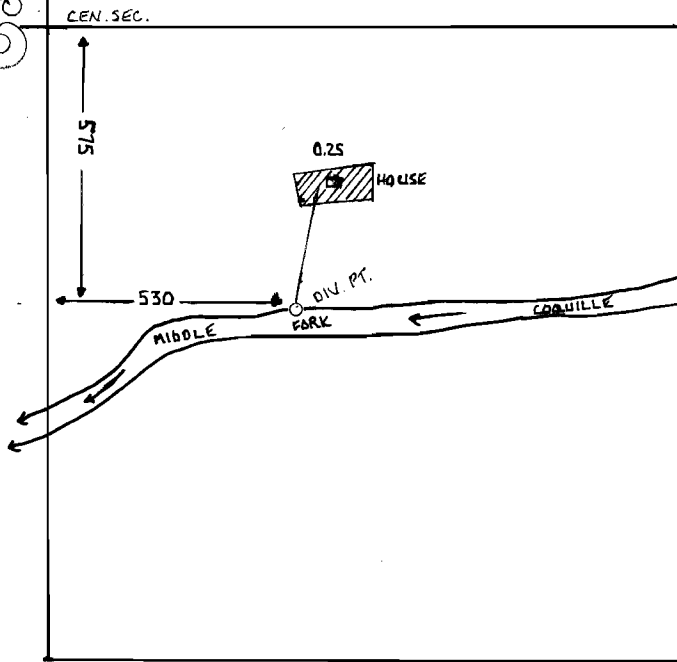

T. 29S, R11W, W.M.

FINAL PROOF SURVEY FOR:

PERMIT 50204
APPL. 69420

IN NAME OF
GARY M'DANIEL

SCALE 1" 400'
AUG. 29, 1989

BY: JOHN PRAHAR C.W.R.E. 107

