


T.16S., R.12W., W.M.

PACIFIC OCEAN

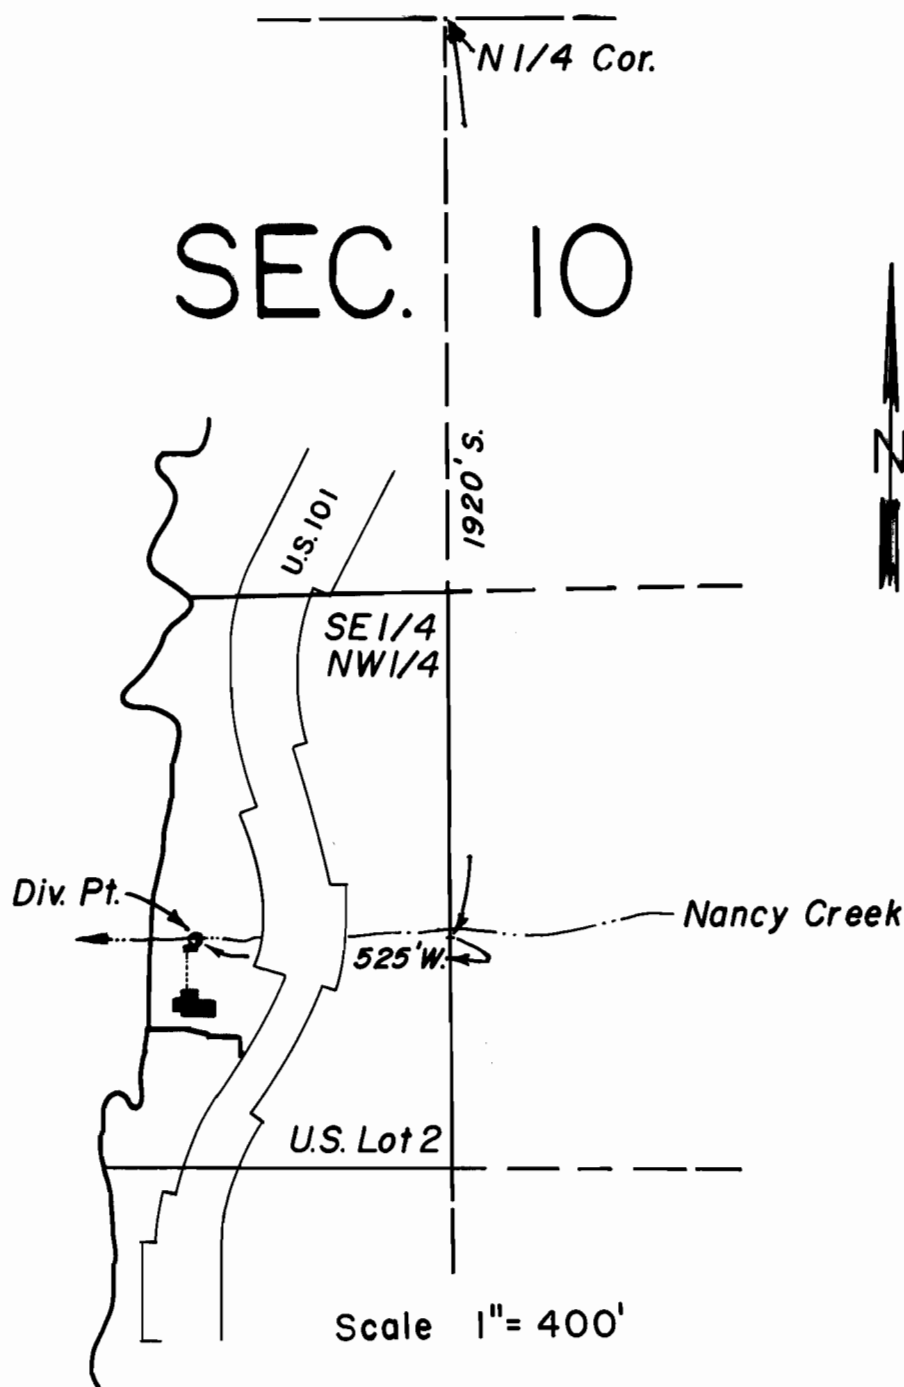

NOTE: THIS MAP IS FOR THE PURPOSE OF LOCATING A
WATER RIGHT AND IS NOT INTENDED TO PROVIDE
LEGAL DIMENSIONS FOR PROPERTY BOUNDARY
LINES.

FINAL PROOF SURVEY
UNDER

Application No. 69686 , Permit No. 50455

IN NAME OF

Ralph and Zelma Newman

Surveyed March 29, 1989 by

