


T.2N.,R.8E.,W.M.

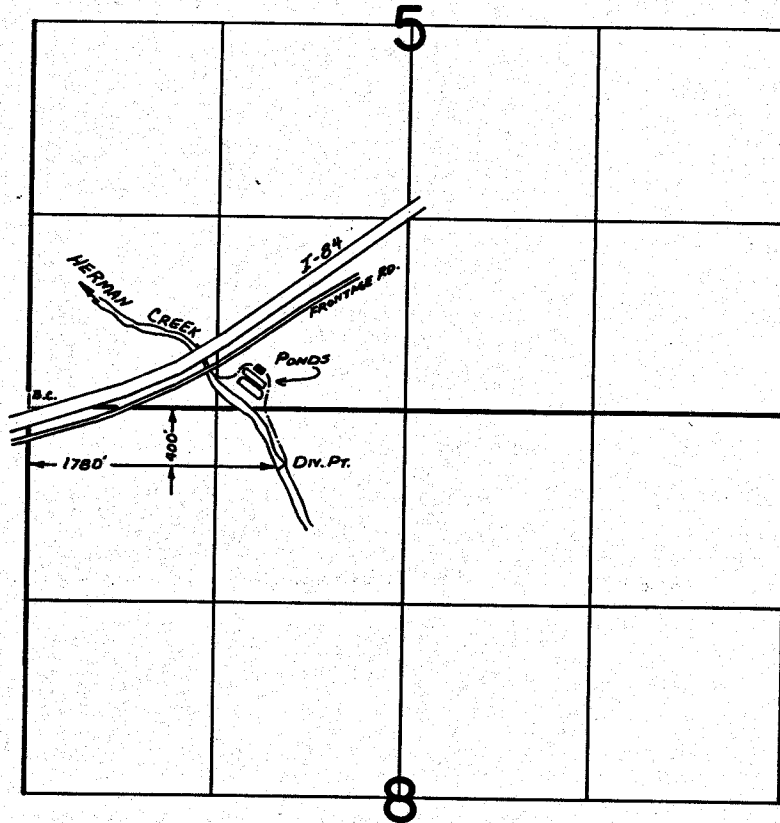

FINAL PROOF SURVEY
UNDER

Transfer No. Q-24
Application No. Permit No.

IN NAME OF

DEPT. OF FISH AND WILDLIFE

Surveyed Feb. 2, 1982, by J. J. PAUL