


T. 8S. R. 39E. W.M.



I.P.  
POND LOC. 370'N & 150'E FROM SW COR SEC 20

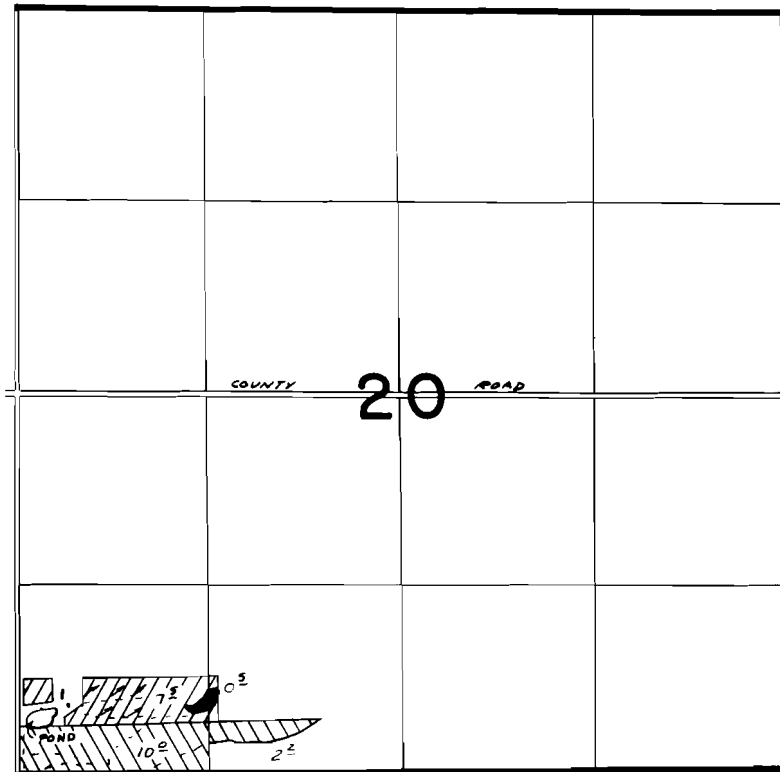

ZIMMERMAN



HARDMAN

**FINAL PROOF SURVEY**  
UNDER

Application No. G-5227 Permit No. G-5085  
IN NAME OF  
WALLACE E. & BETTY M. HARDMAN  
WALTER W. & CATHRYN ZIMMERMAN

Surveyed 6-5 1978, by R. BARWIN