


T. 25S., R. 13E., W.M.

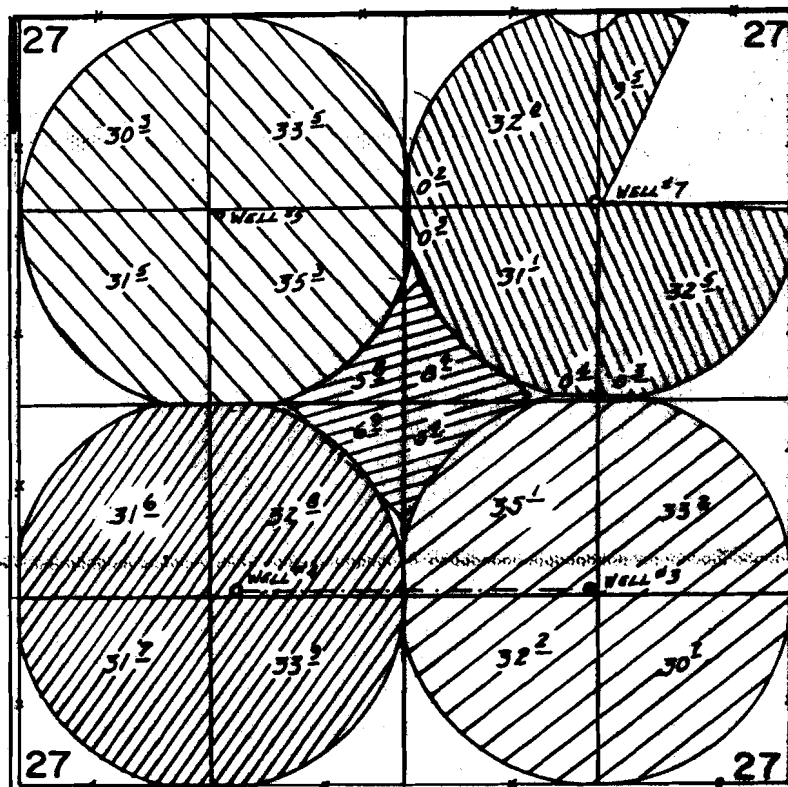

SCALE: 1" = 1320'

WELLS LOC.: #3-1860' N. & 1380' W., #4-1360' N. & 3020' W., #5-3950' N. & 3960' W., #7-1040' N. & 1350' W., ALL FROM SE COR. SEC. 27.

Well 4 Suppl.
Well #5

Well #3 Suppl.
Well #7

Wells #3&4

FINAL PROOF SURVEY UNDER

Application No. G-9867. Permit No. G-9071.....
IN NAME OF

RAY & EDNA WAGNER.....

Surveyed Oct. 17, 1983, by L.M. TOLL.....
Sept. 15, 1985, B.W. BISHOP