


T.26S.,R.7W.,W.M.

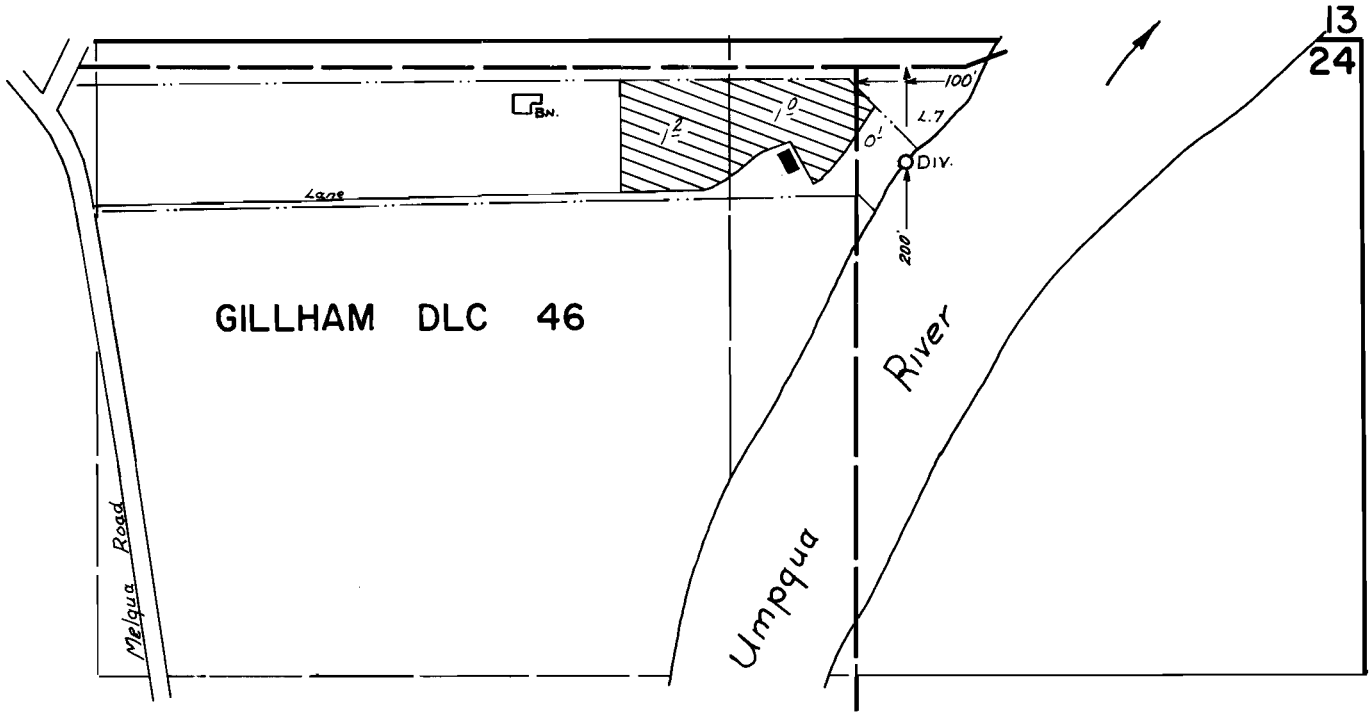

SCALE: 1" = 400'

FINAL PROOF SURVEY
UNDER

Application No. 49808. Permit No. 37468.....

IN NAME OF

.....ROBERT GORDON ILLER.....

Surveyed June 24, 1982, by L. M. TOLL.....