
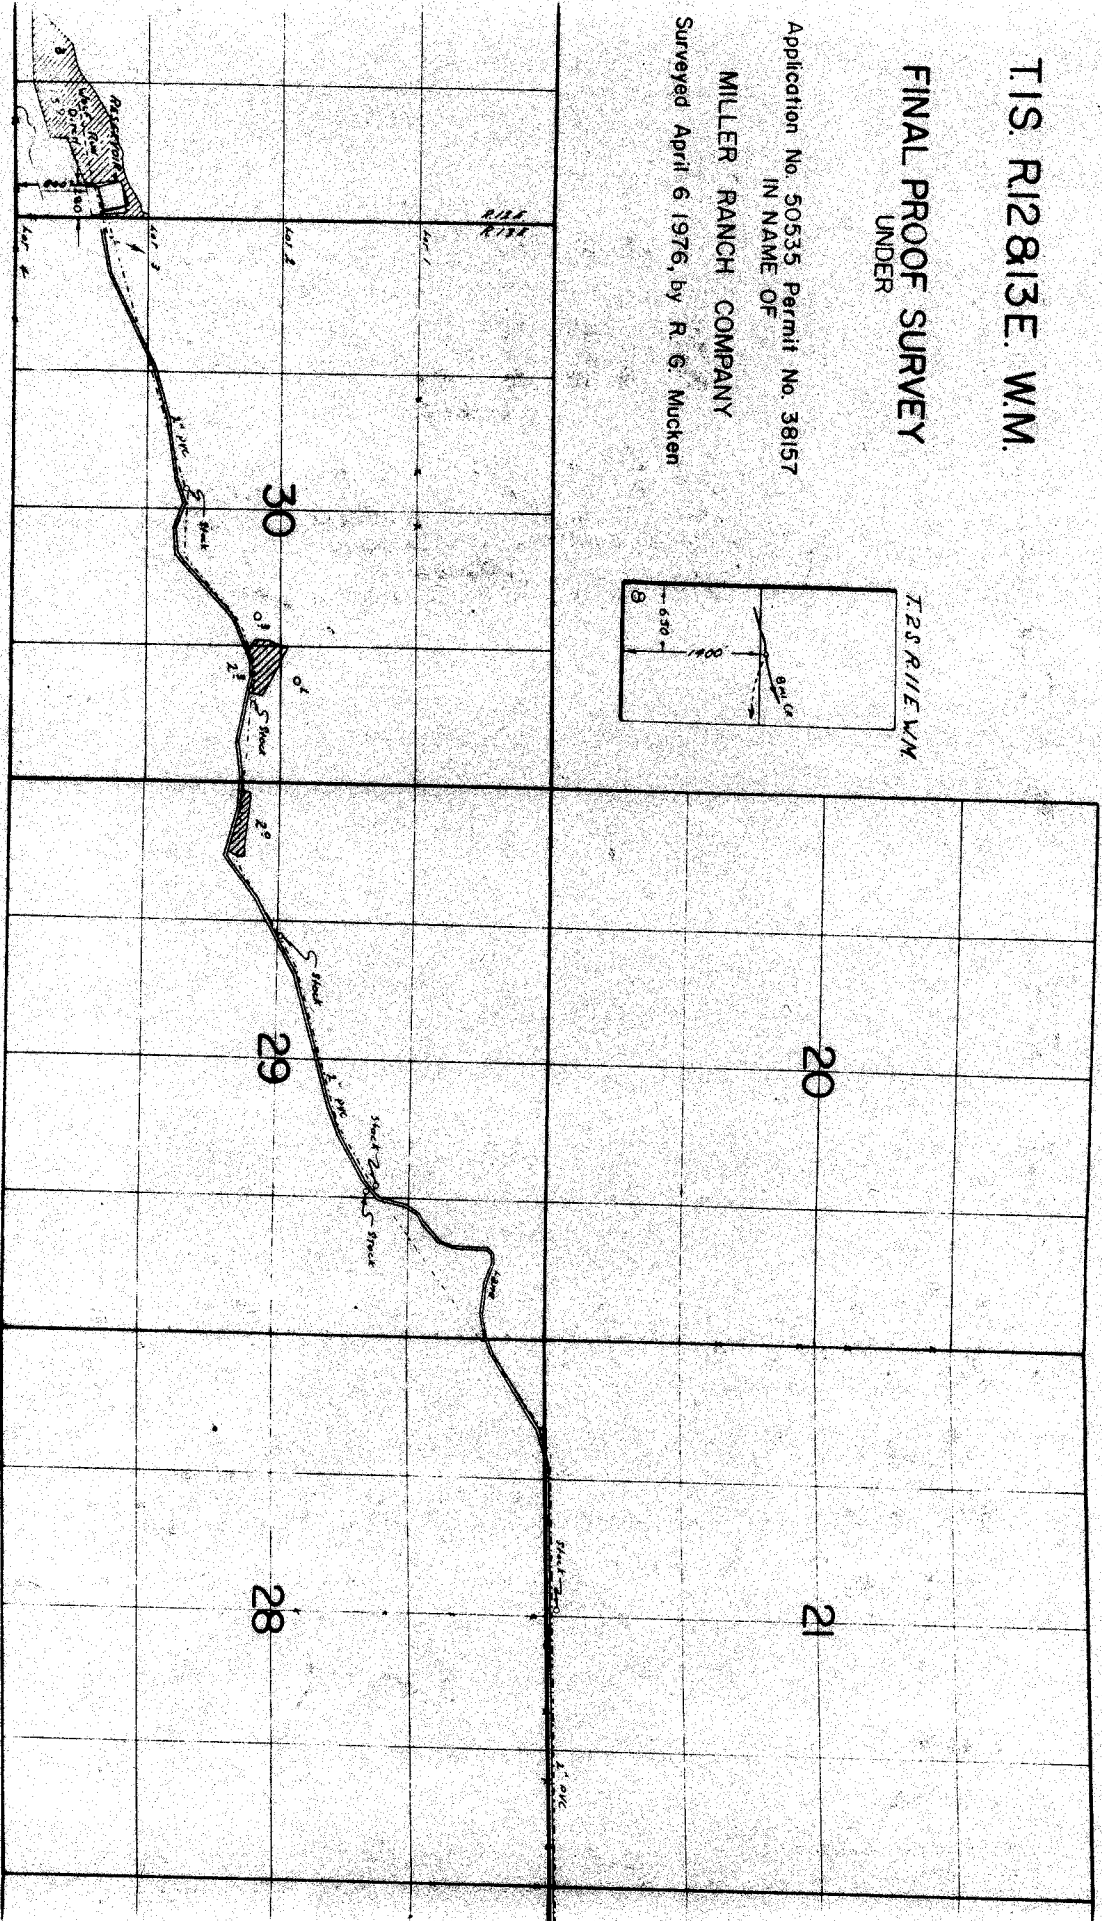


TIS. R12813E. WM.

FINAL PROOF SURVEY
UNDER

Application No. 50535 Permit No. 38157
IN NAME OF
MILLER RANCH COMPANY
Surveyed April 6 1976, by R. G. Muehlen

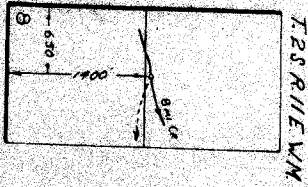


