


T.13S. R.9E. W.M.

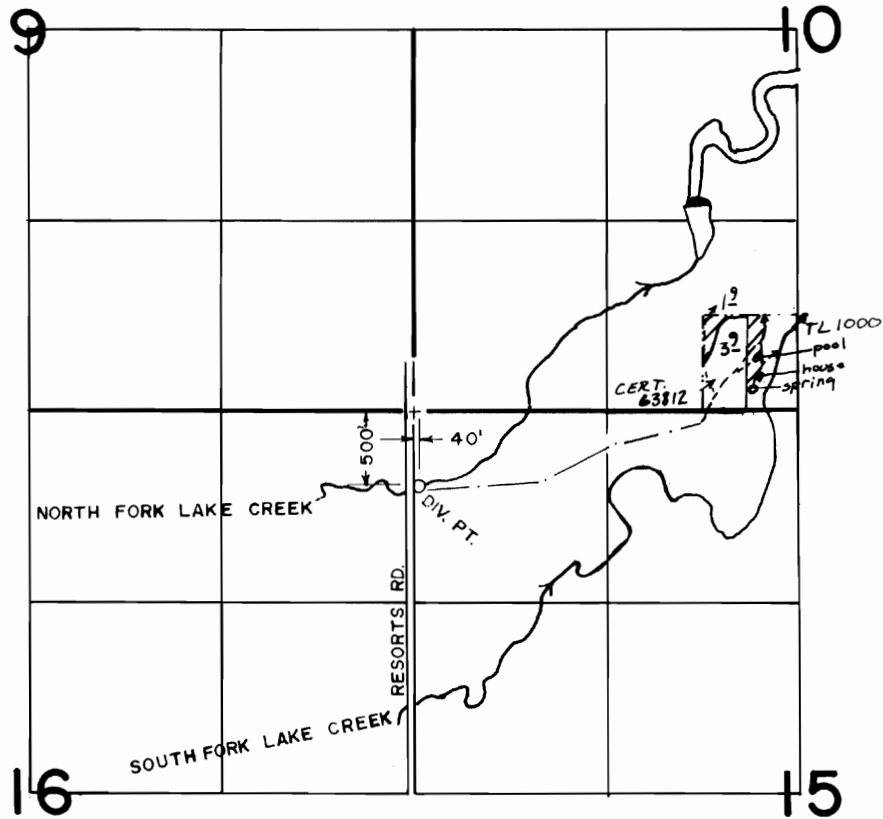

**FINAL PROOF SURVEY**  
UNDER

TRANSER NO. 4166

Application No. 58597... Permit No. 44211.....

IN NAME OF

**IRWIN B. HOLZMAN**

Surveyed APR. 16. 1980., by L.H. NUNN.....