
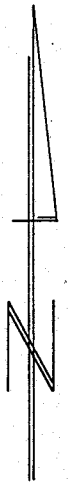



C-64322 P-46889  
C-64365 P-46890

T12S, R26E, WM

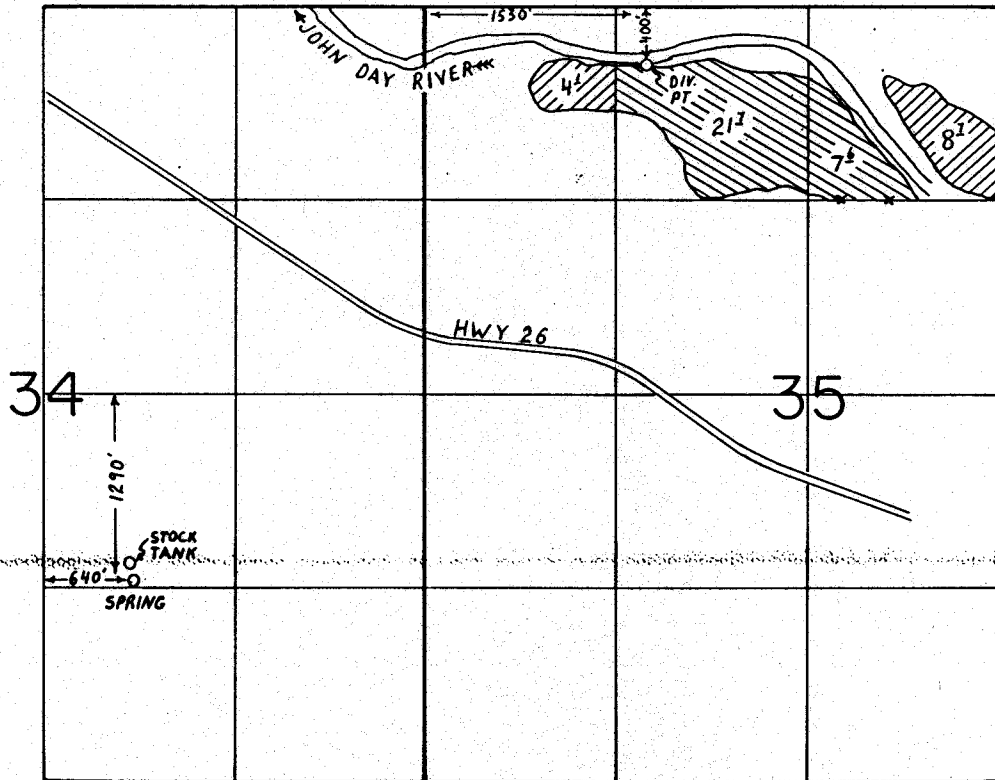

SCALE  
1" = 1320'

### FINAL PROOF SURVEY UNDER

 PRIMARY IRR.

 SUPPLEMENTAL IRR.

62375                      46889  
Application No. 62376. Permit No. 46890....  
IN NAME OF

COTTONWOOD LAND & CATTLE CO., INC.

Surveyed JUNE 18, 1988, by T.M. WARREN.