


# T.31S.R.15W.W.M.

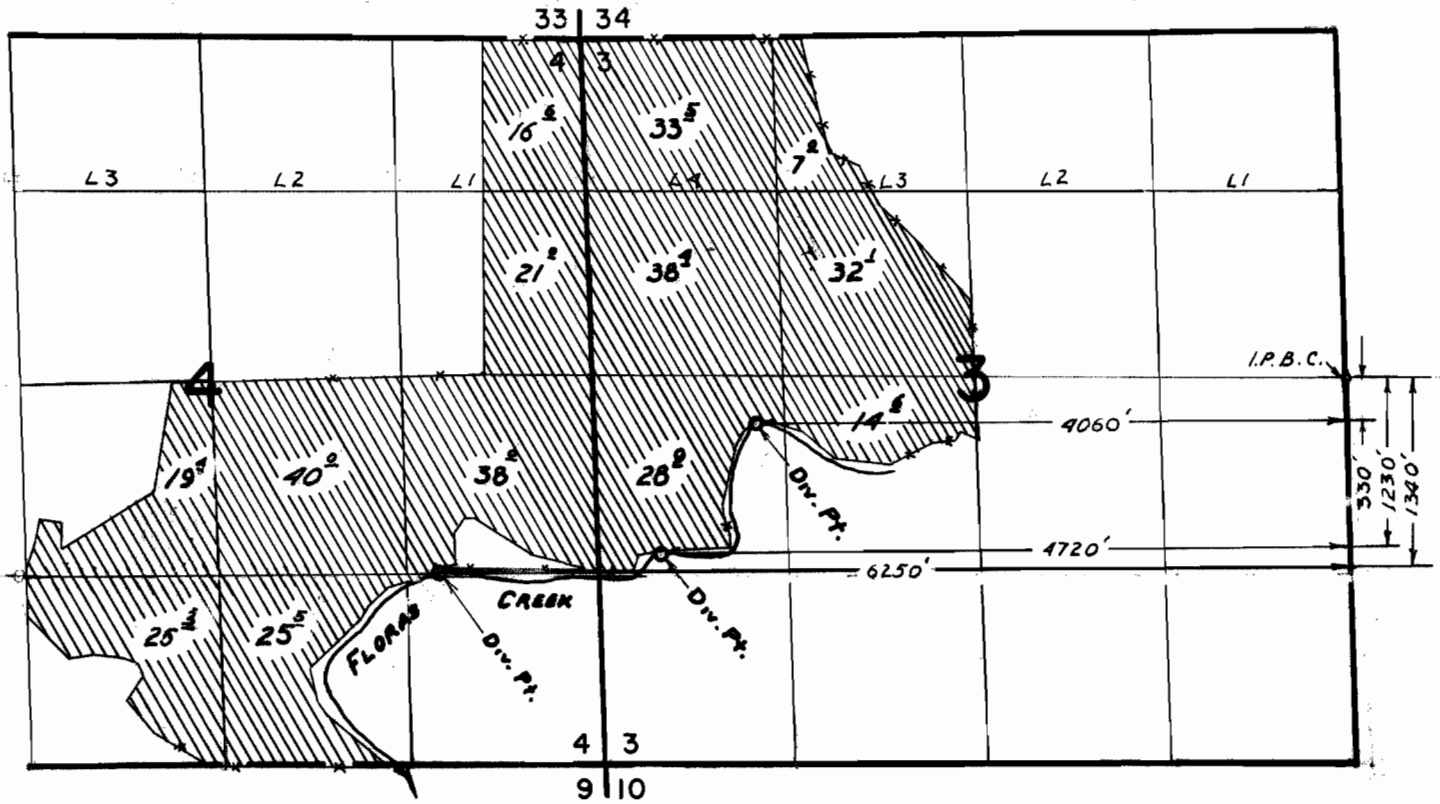

## FINAL PROOF SURVEY UNDER

Application No. 3976.3. Permit No. 297.7.2.  
IN NAME OF

RODERICK T. MCKENZIE

Surveyed May 17, 1969, by L. E. Gould