


T.35S. R.5W.W.M.

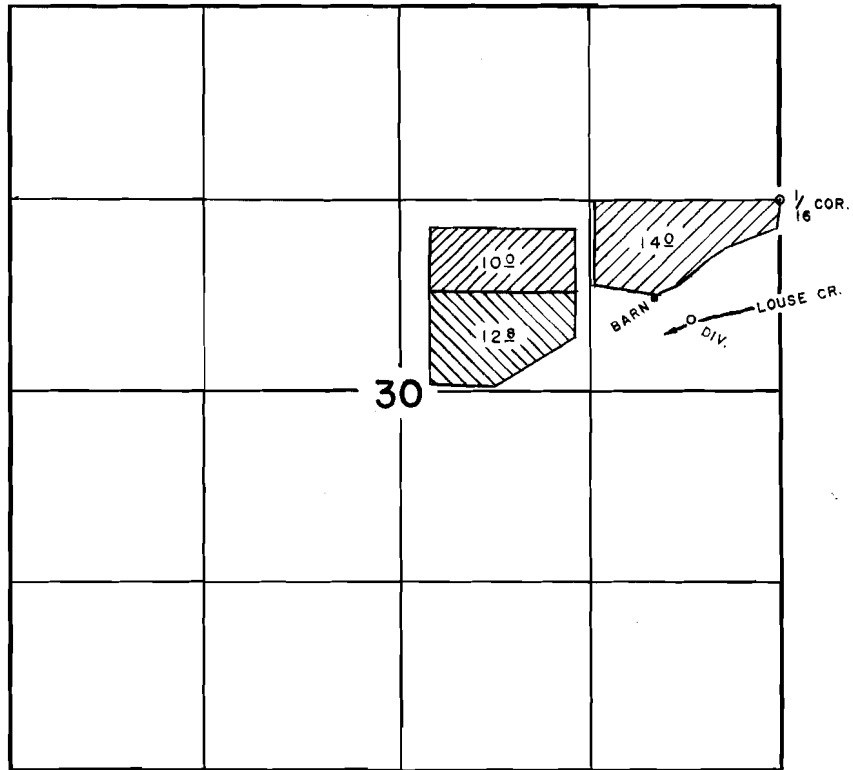

1920 PRIORITY



1964 PRIORITY

FINAL PROOF SURVEY UNDER

Transfer No. W-119
and

Application No. 39930 Permit No. 29720
IN NAME OF

ERNEST J. WALSH, M.D.

Surveyed Sept. 27, 1966, by R. B. STEIMER