


T. 5 S. R. 1 E. W. M.

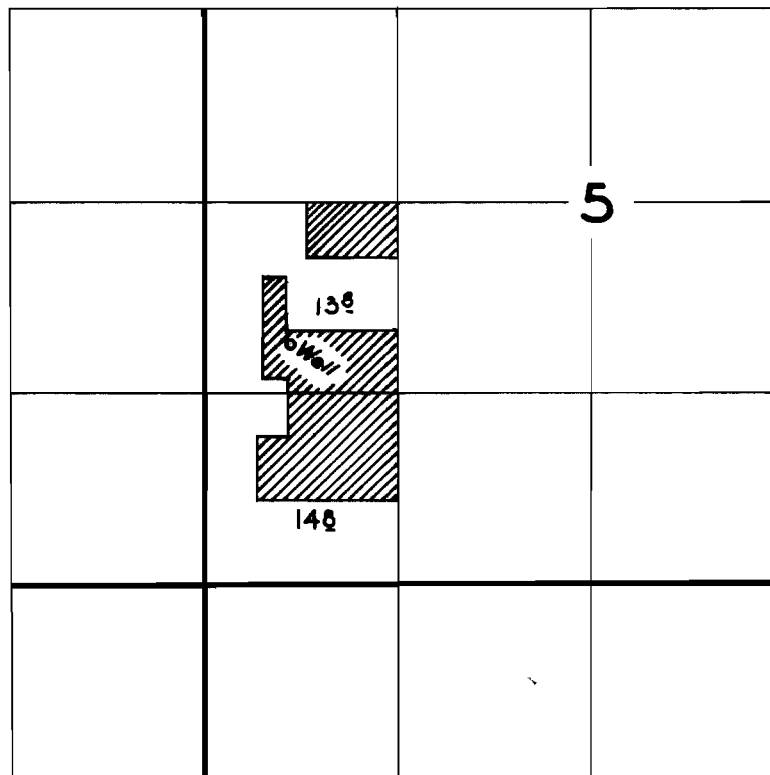

FINAL PROOF SURVEY
UNDER

Application No. G-493 Permit No. G-387
IN NAME OF

DANIEL H. YODER

Surveyed 14 August 1958, by C.O. Bartels