


T.34S., R.6W., W.M.

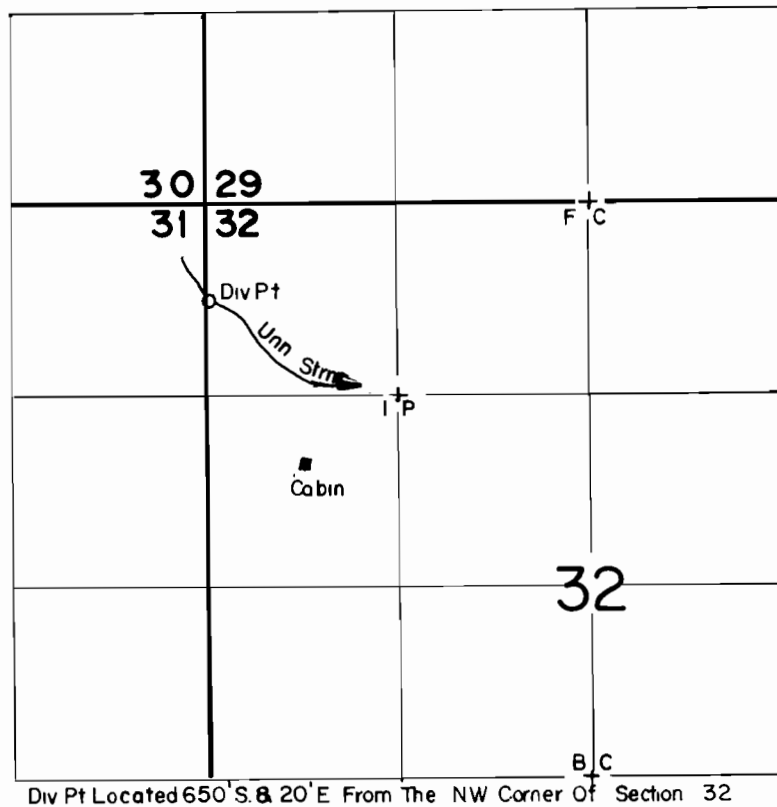

SCALE: 1"=1320'

FINAL PROOF SURVEY
UNDER

Application No. 48709... Permit No. 36078.....
IN NAME OF

.....TIMOTHY J. DRESSEL.....

Surveyed JUNE 14, 1989., by B.S. JAMES.....