


G5663

L4335

T. 2 N., R. 27 E. W. M.  
Scale 4" = 1 mile

**RECEIVED**  
MAR 10 1973  
**STATE ENGINEER**  
SALEM, OREGON

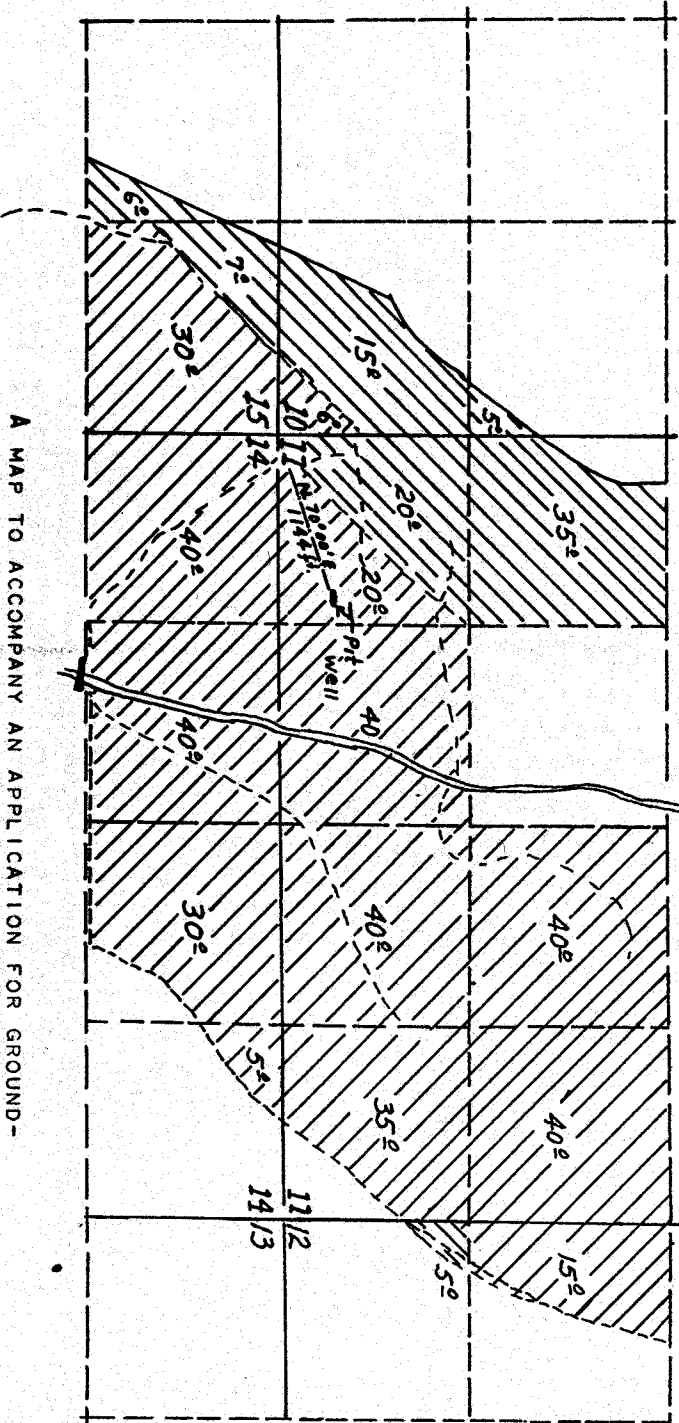

A MAP TO ACCOMPANY AN APPLICATION FOR GROUND-  
WATER IN THE NAME OF JERRY E. MYERS OF RT. 2,  
HEPPER, OR 97836.

**Application No. G-5974**  
**Permit No. G 5663**