


T. 14 S., R. 5 W., W.M.

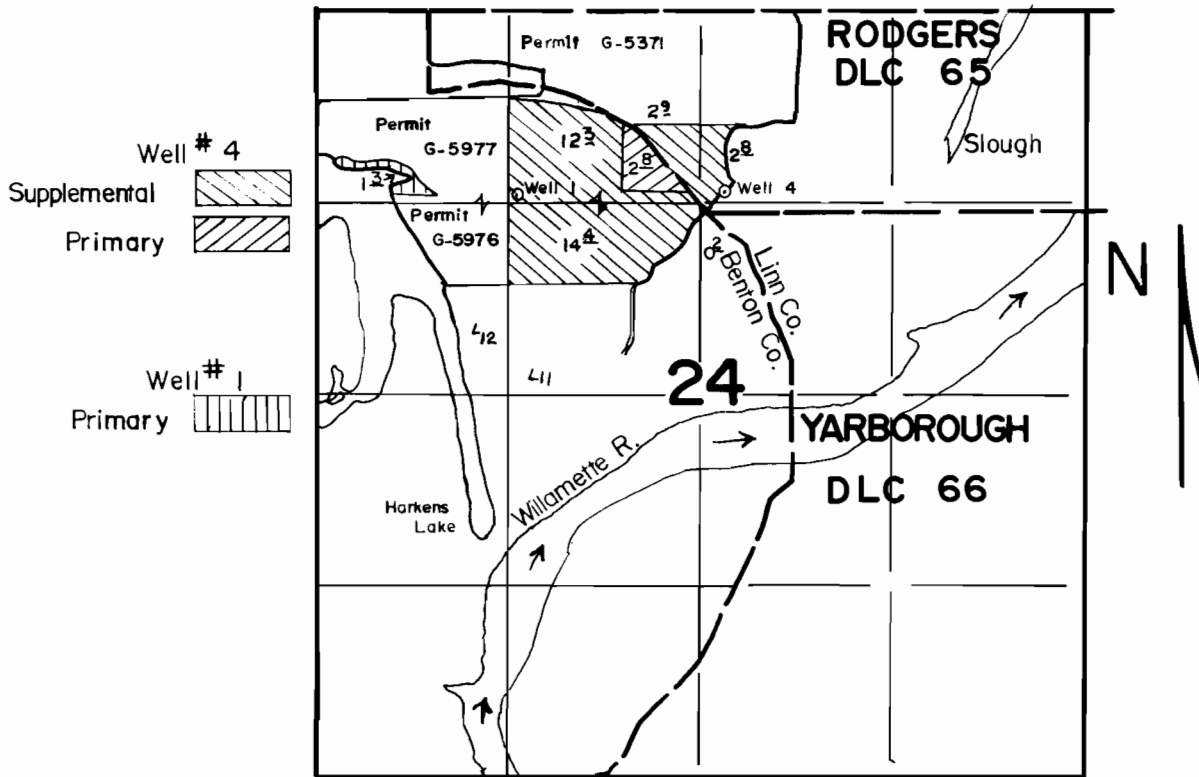

Well 1 Loc.: 1260' S. & 1380' E. from the NW Cor. Section 24

Well 4 Loc.: 1250' S. & 2800' E. from the NW Cor. Section 24

Scale: 4" = 1 Mile

FINAL PROOF SURVEY UNDER

Application No. ~~G-8588~~ Permit No. ~~G-8014~~.....
IN NAME OF

.....**GUY M. GILMORE**.....

Surveyed **JULY 13, 1983**, by **L. TOLL**.....