


T.17 S., R.27 E., W.M.

G-9744
64342

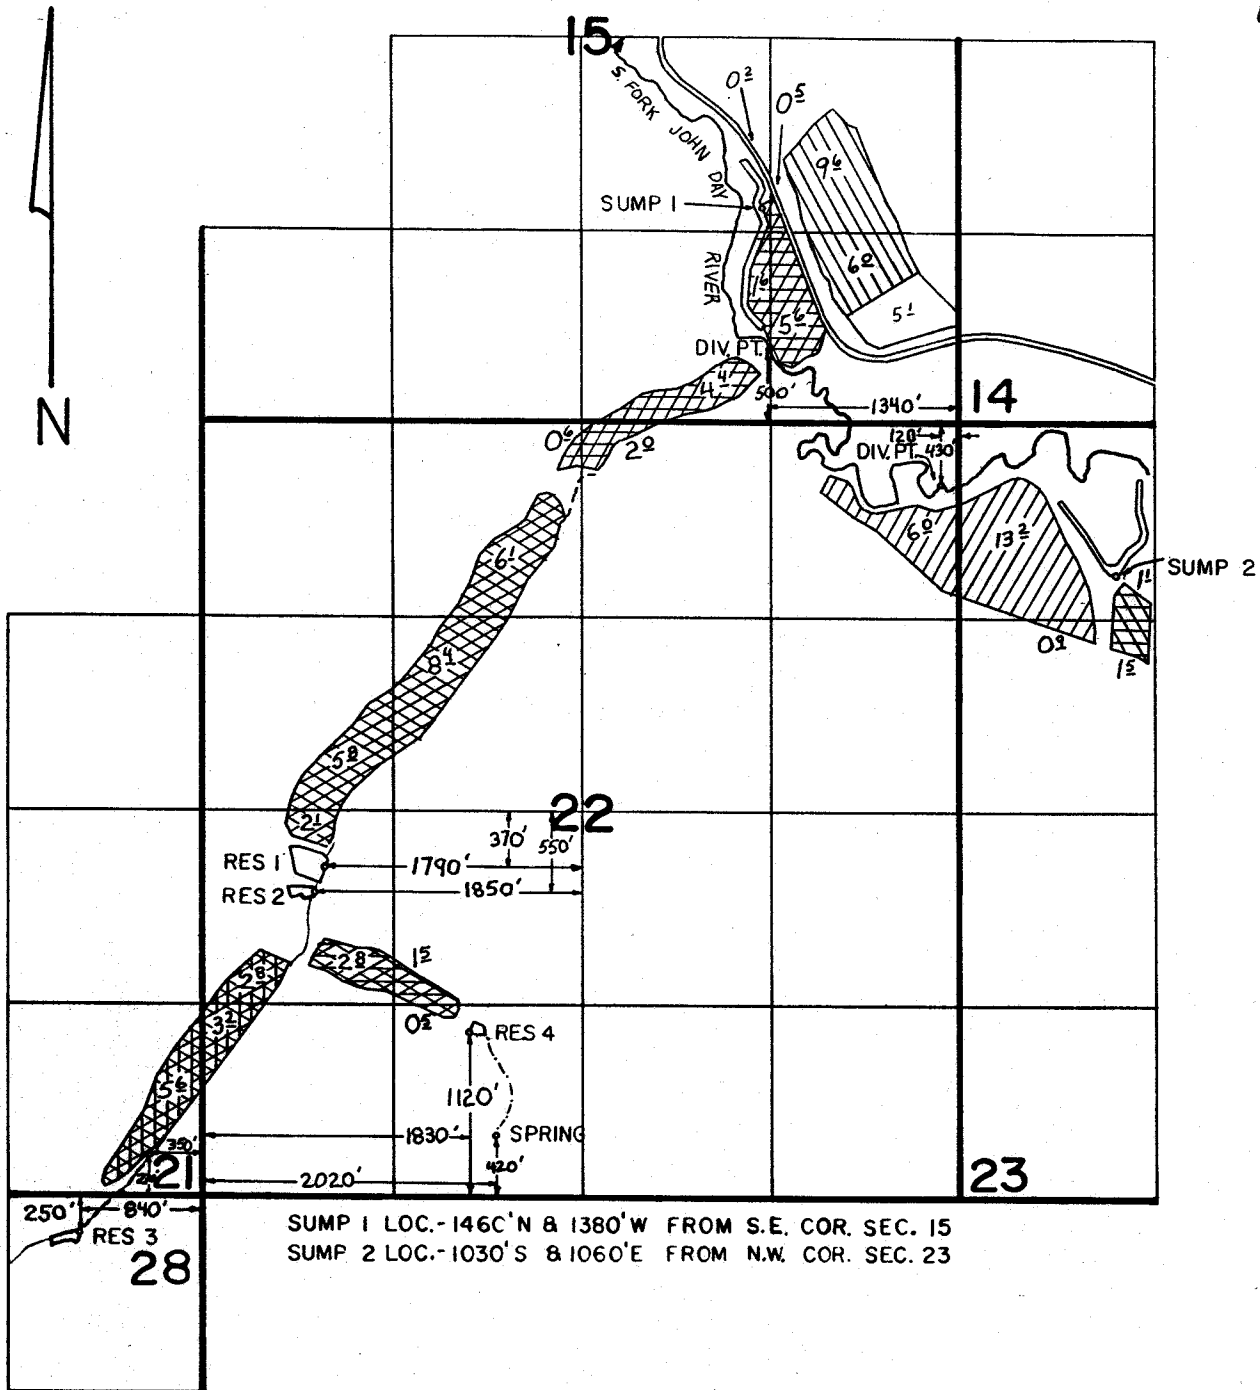

SUMP 1 LOC. - 146' N & 1380' W FROM S.E. COR. SEC. 15
SUMP 2 LOC. - 1030' S & 1060' E FROM N.W. COR. SEC. 23

FINAL PROOF SURVEY

UNDER

G10505 G9744
62168 46736
62170 46681

Application No. R.62169... Permit No. R.8402.....

IN NAME OF

W.R. ROGERS

Surveyed April 23, 1986, by J.M. Toll.....

G9744	SUMP 1	SUMP 2
46736	DIV. PT. 1	DIV. PT. 2
46681	RES 1&2	RES 3
	RES 4	