


# T. 6 S., R. 1 E., W.M.

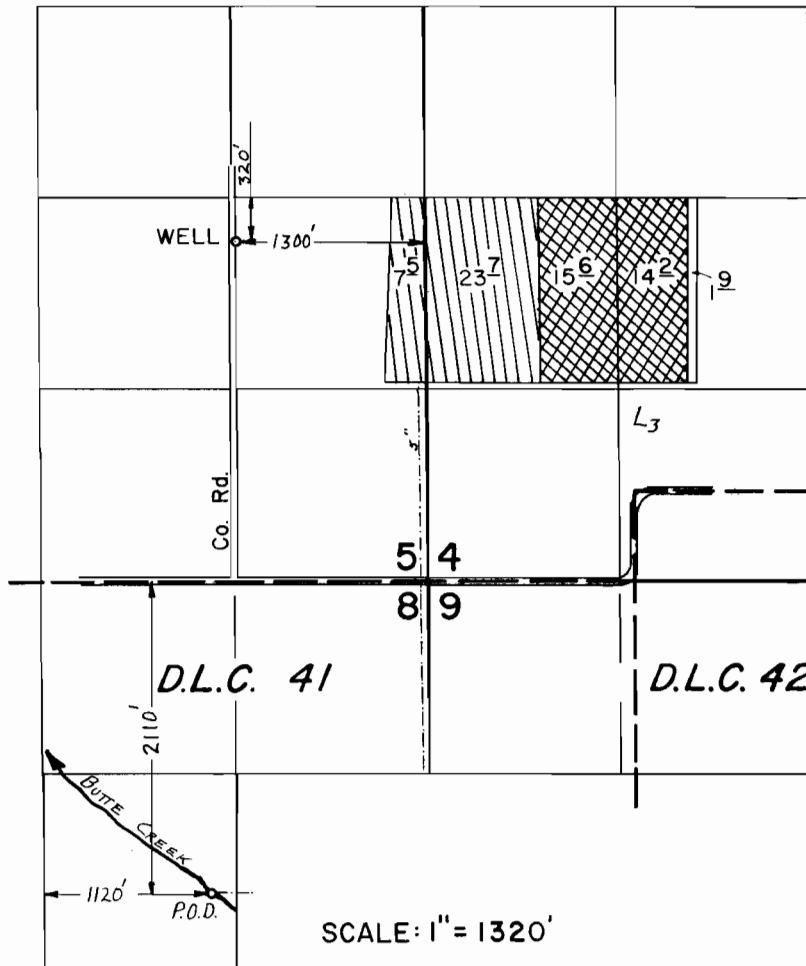

*Copy from  
G-3608*

## FINAL PROOF SURVEY UNDER

63602

46857



Primary



Supplemental

Application No. G-10740 Permit No. G-9820



Supplemental

IN NAME OF

VICTOR & PHYLLIS SCHNEIDER

Surveyed JUNE 14, 1985, by T. WARREN