


T.18S., R.11W., W.M.

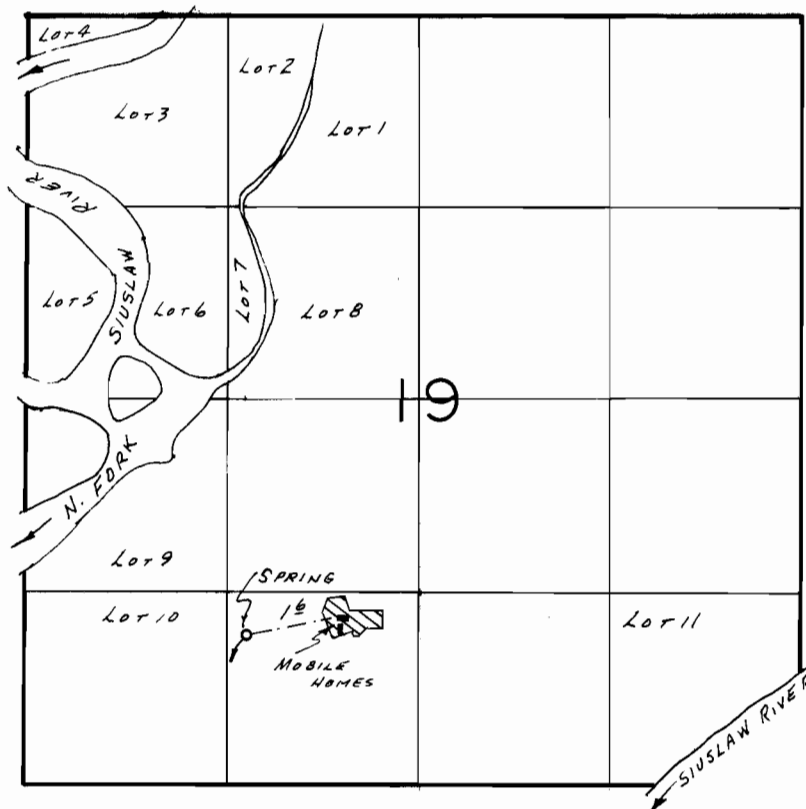

SPRING LOC.: 1020' N. & 1540' E. FROM SW COR. SEC. 19

SCALE: 1" = 1320'

FINAL PROOF SURVEY UNDER

Application No. 64570.. Permit No. 47334.....
IN NAME OF

LEIF R. & SUZANNE E. DANIELSON

Surveyed July 29, 1986, by B.W. BISHOP.....

12/30/86
BWB

PTS 1986B