


T. 5 S., R. 1 E., W.M.

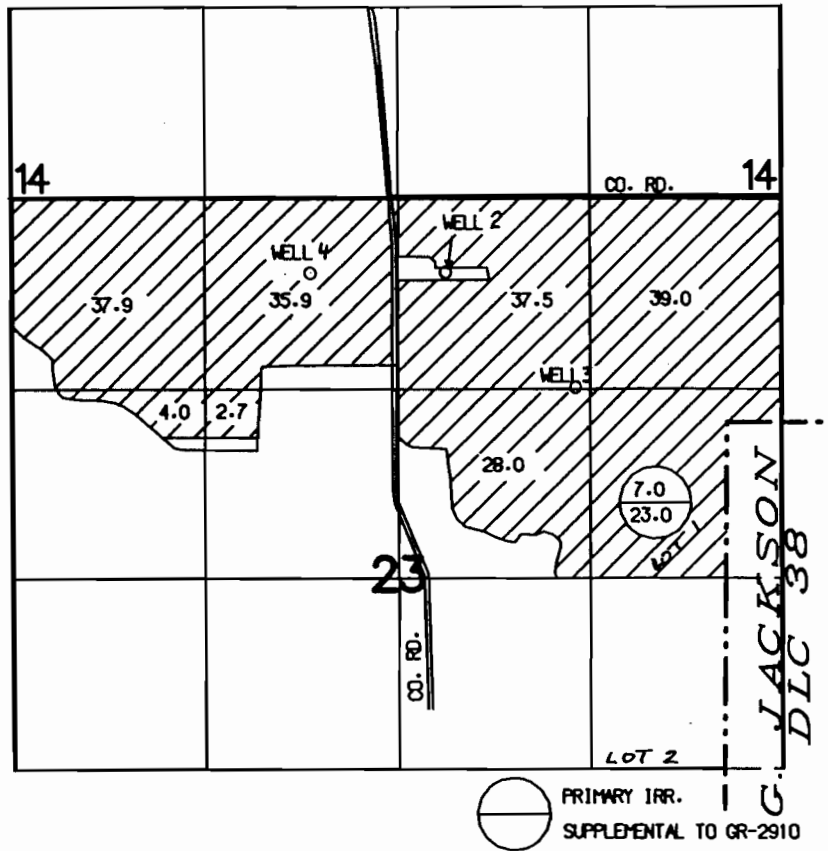

WELL LOCATIONS FROM THE N 1/4 CORNER SECTION 23

NUMBER 2: 500 FT S AND 340 FT E

NUMBER 3: 1320 FT S AND 1220 FT E

NUMBER 4: 520 FT S 600 FT W

FINAL PROOF SURVEY
UNDER

Application No.: G-11390 Permit No.: G-10500
IN THE NAME OF

CRESTVIEW FARMS

Surveyed: JUNE 10, 1986

By: T. M. WARREN

RWK

41005 278 146R