


T.2S. R.5E. W.M.

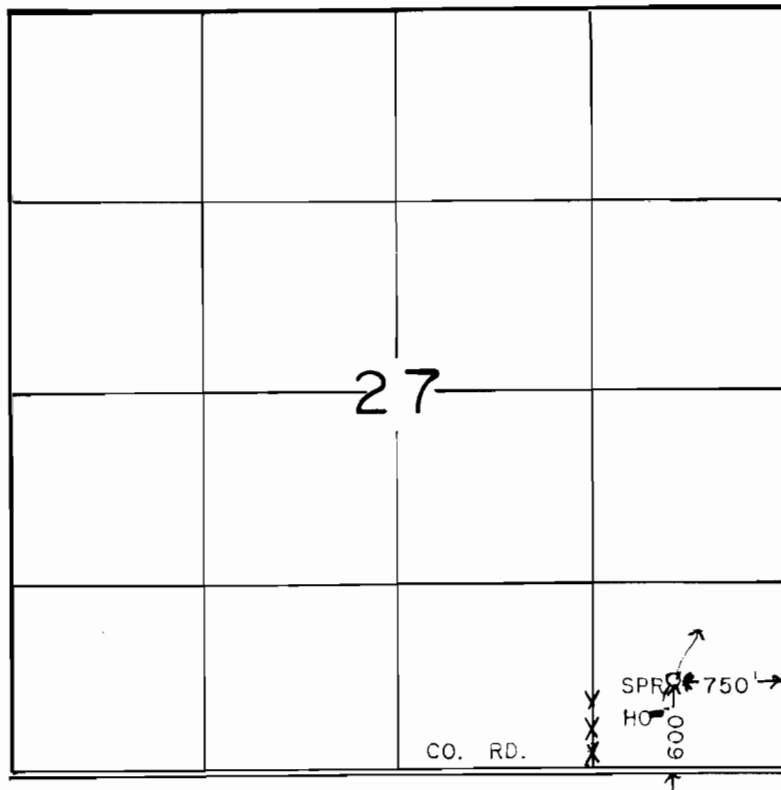

SCALE: 1" = 1320'

FINAL PROOF SURVEY
UNDER

Application No. 60355 Permit No. 45582
IN NAME OF

ROBERT G. & NANCY F. STOCHOSKY

Surveyed JULY 29, 1987, by T.M. WARREN